


County Surveyor's Record, Douglas County, Oregon

Subdivisions of T. 22 S., R. 10 W.

CHAINS

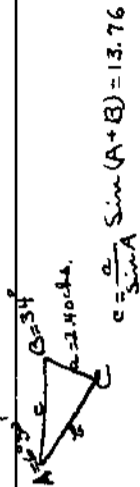

A myrtle, 8 ins. diam., bears N.25*E. 12 lks. dist. marked T 22 S R 10 W S 13 M C B T.

An alder, 16 ins. diam., bears S.30*W. 35 lks. dist. marked T 22 S R 10 W S 24 M C B T.

I send a flag across the river and set it on line. I then go across the river and run a base S.56*W. 2.40 chs. angle opposite 61 1/2*, distance across 13.76 chs.

35.55 **Opposite** bank, edge of water.

37.00 Set a post, 4 ft. long, 4 ins. sq., 24 ins. in the ground for meander cor. bet. secs. 13 & 24, marked T 22 S R 10 W M C on W., S 13 on N., S 24 on S. faces, from which A myrtle, 5 ins. diam., bears S.62*W. 238 lks. dist. marked T 22 S R 10 W S 24 M C B T.

Land, mountainous, 15 chs.

Soil, 1st rate near river, 7 chs. 3rd rate on mountain.

Dense underbrush, hazel, thimbleberry, vine maple & sallal, 15 chs.

July 7, 1894.

From the cor. to secs. 13, 14, 23 & 24, I run West, along established line.

Var. 20*15'E.

Along S. slope.

Ascend.

6.00 Top of spur, course S.

14.00 Enter bottom

19.24 Intersect river and set a post, 4 ft. long, 4 ins. sq., 24 ins. in the ground for meander cor. bet. secs. 14 & 23, marked T 22 S R 10 W M C. on W., sec. 23 on S., S 14 on N. faces, from which

A myrtle, 6 ins. diam., bears N.55*E. 9 lks. dist. marked T 22 S R 10 W S 14 M C B T.

A myrtle, 6 ins. diam., bears S.30*E. 9 lks. dist. marked T 22 S R 10 W S 24 M C B T.

50

150