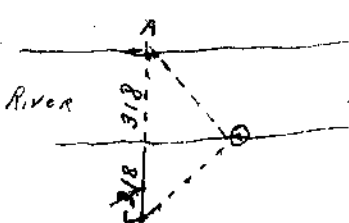


Subdivisions of T. 26 S., R. 3 W.

| CHAINS | | |
|--------|---|------|
| | <p>ground, from which</p> <p>A cedar, 8 ins. diam., bears N.24*E., 18 lks. dist.</p> <p>A cedar, 8 ins. diam., bears S.64*E., 30 lks. dist.</p> | |
| 43.40 | A stream, 10 lks. wide, course N. | |
| 63.25 | A stream, 15 lks. wide, course NW. | |
| 64.00 | Begin ascent | |
| 80.00 | <p>Marked a white fir, 5 ins. diam., for the cor. to secs. 10, 11, 14 and 15, from which</p> <p>A red fir, 16 ins. diam., bears N.72*E., 23 lks. dist.</p> <p>A maple, 10 ins. diam., bears S.77*E., 19 lks. dist.</p> <p>A white fir, 6 ins. diam., bears S.72*W., 11 lks. dist.</p> <p>A red fir, 30 ins. diam., bears N.46*W., 25 lks. dist.</p> | +200 |
| | <p>Land, rolling 2d rate.</p> <p>Timber, fir, cedar, sugar pine, laurel and oak.</p> <p>Underbrush, hazel, vine maple and same as old growth.</p> | |
| | <p>North, on true line, bet. secs. 10 and 11.</p> <p style="text-align: right;">Va. 18*30'E.</p> | |
| 9.50 | A stream, 1 lk. wide, course NW. | -100 |
| 30.00 | Enter river bottom, course E and W. | -500 |
| 36.00 | Intersect S bank of the N Umpqua River and set post on N side of same. | |
| | <p>Thence, from a point due E of point of intersection, the post on N bank was N.42½*W. Thence, marked a point S.42½*W at intersection of established line and measured distance from river to said point of intersection 3.18 chs., the distance across river.</p> | |
| |  | |