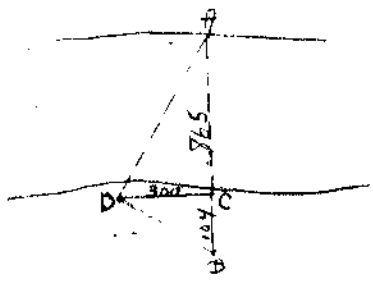


Subdivisions and Meanders of Umpqua River in Township 26 S.,  
R. 4 W., W. M.

CHAINS	<p>A W. Oak, 7 ins. dia., bears S.18*W., 18 lks. dist.</p> <p>An Ash, 3 ins. dia., bears N.12*E., 32 lks. dist.</p> <p>40.00 Quarter post, coming in river could not be established.</p> <p>41.15 To north bank. Set meander post from which,</p> <p>An alder, 6 ins. dia., bears S.5 *W., 8 lks. dist.</p> <p>A W. Oak, 6 ins. dia., bears N.25*E., 67 lks. dist.</p> <div style="display: flex; align-items: center;">  <div style="margin-left: 20px;"> <p>Distance across river obtained as follows, viz.</p> <p>Caused a flag to be placed on line on west bank of river at A.</p> <p>Measured BC=300 lks.</p> <p>Constructed the angles BCD &amp; ABC= right angles &amp; measured CD=104 lks</p> <p>Then by similarity of triangles, we have,</p> <p style="text-align: center;">104 : 300 :: 300 : 865.</p> </div> </div> <p>77.60 Intersect west township line, 14 lks. N. of post corner of Secs. 18 &amp; 19, from which corner I run, N.89*54'E.,<sup>East,</sup> on true line between Secs. 18 &amp; 19.</p> <p>The corner for 1/4 Sec. post falling on river, it cannot therefore be established.</p> <p>77.60 To post corner of Secs. 17, 18, 19, &amp; 20.</p> <p>Land, 2nd rate, with some patches of 1st rate prairie. Timber, oak, ash &amp; laurel.</p>
	Va. 162 <sup>3</sup> *E.
2.50	Fence, N. & S.
25.00	Fence N. & S.
40.00	Set 1/4 Sec. post from which,
	<p>A W. Oak, 8 ins. dia., bears S.20*E., 140 lks. dist.</p> <p>A W. Oak, 12 ins. dia., bears S. 5*W., 895 lks. dist.</p>
40.00	Leave prairie.
52.73	To meander post on South or left bank of Umpqua River, from which,
	<p>An Ash, 7 ins. dia., bears S.10*W., 23 lks. dist.</p> <p>Maple, 6 ins. dia., bears East., 9 lks. dist.</p>