

County Surveyor's Record, Douglas County, Oregon

Subdivision of T. 25 S., R. 1 E.

CHAINS

N.0°02'W., bet. secs. 27 and 28.


Desc. 285 ft. along E. slope, through heavy timber and dense undergrowth.

1.70 Continue desc. over NE. slope.

6.10 Top of bluff, 70 ft. high, faces NE.

10.61 Point for triangulation at top of bluff on south rim of Black Gorge. From this point, the line descends 100 ft. over series of bluffs into Steamboat Creek, course W., in bottom of gorge, and then ascends over series of bluffs to top of north rim of gorge.

Project line across gorge to point above north rim, and lay off a base N.89°58'E., 2.23 chs. (longer base impossible) to a point whence the point for triangulation on south rim bears S.20°33'W.

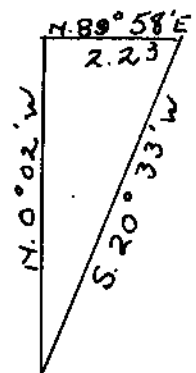

Dist. on line 10.61 chs.

Dist. by triangulation 5.94 " 16.55 "

15.50 Top of bluffs on north rim of Black Gorge, bears E. and W.; asc. 500 ft. over SW. slope.

16.55 Point for triangulation.

26.25 Steamboat trail and Forest Service telephone line, bears NW. and SE.

29.75 Continue asc. along broken E. slope.

40.00 Set an iron post, 3 ft. long, 1 in. diam., 27 ins. in the ground, for 1/4 sec. cor., with brass cap marked

1/4  
S28 | S27  
1927

from which