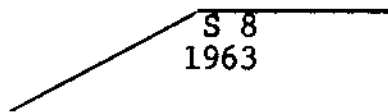


## County Surveyor's Record, Douglas County, Oregon

Dependent Resurvey, Portion Subdivisional Lines, T. 22 S., R. 8 W.

CHAINS

T 22 S R 8 W  
C 49

Reset the iron pipe alongside the iron post.

S. 87° 49' W., beginning new measurement.

Descend 5 ft. over gentle W. slope.

13.80 Creek, 3 lks. wide, course S. 65° E.; asc. 20 ft. over general E. slope.

22.35 State Highway No. 38, 35 lks. wide, bears N. 65° E. and S. 65° W.

34.05 Leave field and begin steep ascent; edge bears N. 65° E. and S. 65° W.; asc. 290 ft. over SE. slope, changing to S. slope.

38.76 The cor. of secs. 5, 6, 7, and 8.

Land, mountainous.

Soil, sandy clay loam.

Timber, fir, hemlock, cedar, maple, oak, alder, and cascara; undergrowth, fern, salal, hazel, poison oak, and vine maple.


N. 0° 13' E., bet. secs. 5 and 6.

Ascend 335 ft. over broken SE. slope, across old burn, through dense undergrowth.

9.40 Spur ridge, bears N. 50° E. and S. 50° W.; desc. 10 ft. over NW. slope.

9.80 Intersect the NW. bdy. of Donation Land Claim No. 49, and point for closing corner.

Set an iron post, 28 ins. long, 2½ ins. diam., 22 ins. in the ground, with brass cap marked

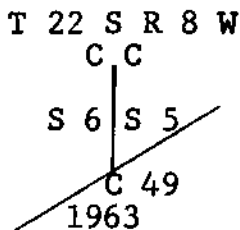

from which

A fir, 9 ins. diam., bears N. 8½° W., 101 lks. dist., mkd. S6 CC BT.

No other suitable bearing tree available.

Set a 7 ft. steel fence post, 24 ins. in the ground, alongside the iron post.

From this point the SW. cor. of Claim 49, which is also the cor. of Claims 48 and 58, bears S. 39° 25' W., 107.35 chs. dist., hereinafter described.

Descend 60 ft. over broken NW. slope.