

County Surveyor's Record, Douglas County, Oregon

14823

Subdivision of Section 15, T. 29 S., R. 6 W.


CHAINS

Ascend 180 ft. over S. slope, through heavy timber and light undergrowth, marking and blazing the true line.

6.62 Spur, slopes N. 75° E.; desc. 325 ft. over NE. slope.

19.20 Point for the center S 1/16 sec. cor. of sec. 15.

Set an iron post, 28 ins. long, 2 1/2 ins. diam., 24 ins. in the ground, with brass cap marked

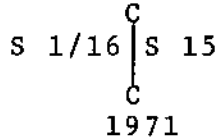

from which

A myrtle, 10 ins. diam., bears N. 1° E.,
113 lks. dist., marked CS 1/16 S15 BT.

A fir, 18 ins. diam., bears N. 44° W.,
65 lks. dist., marked CS 1/16 S15 BT.

Descend 40 ft. over NE. slope.


21.35 Dry creek, 2 lks. wide, drains E.; asc. 95 ft. over SE. slope.

24.46 Spur, slopes S. 70° E.; desc. 265 ft. over NE. slope.

33.21 East Willis Creek Road, bears N. 60° W. and S. 60° E.

38.40 Point for the center 1/4 sec. cor. of sec. 15, at intersection with the E. and W. center line.

Set an iron post, 28 ins. long, 2 1/2 ins. diam., 24 ins. in the ground, with brass cap marked

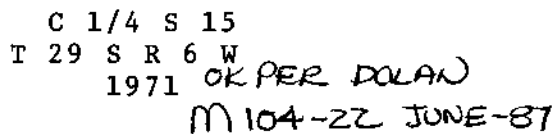

from which

A maple, 23 ins. diam., bears N. 71° E.,
200 lks. dist., marked C 1/4 S15 BT.

An ash, 23 ins. diam., bears S. 85° W.,
240 lks. dist., marked C 1/4 S15 BT.

From this point a locally established point, bears N. 39° W., 0.096 chs. dist., monumented with a steel axle, 1 in. diam., firmly set, protruding 2 ins. above ground, from which a bearing tree

A myrtle, 16 ins. diam., bears N. 45° E.,
48 lks. dist., with healed blaze.

Descend 15 ft. over nearly level land.

39.30 East Willis Creek, 3 lks. wide, course N. 70° W.; asc. 130 ft. over S. slope.

51.15 Spur, slopes S. 85° W.; desc. 20 ft. over NW. slope.

54.70 Dry creek, 2 lks. wide, drains S. 70° W.; asc. 95 ft. over S. slope.

60.00 Spur, slopes S. 80° W.; desc. 140 ft. over NW. slope.