


County Surveyor's Record, Douglas County, Oregon

Dependent Resurvey, Portion of Subdivisional Lines
T. 27 S., R. 8 W., Willamette Meridian, Oregon

17045

CHAINS

T 27 S R 8 W

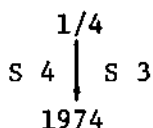

from which the remains of the original bearing trees

A burned fir stump, 74 ins. diam., bears S. 9° E.,
294 lks. dist.; no marks visible.

A burned cedar snag, 50 ins. diam., bears S. 55° W.,
324 lks. dist., with burned blaze.


and bearing trees mkd. by Shaner

A fir, 16 ins. diam., bears S. 4° E., 18 lks.
dist., with healed blaze.

A fir, 20 ins. diam., bears N. 31° W., 29 lks.
dist., with healed blaze.

From this same point, the cor. of secs. 2, 3, 10, and 11,
bears N. 88° 46' E., 81.94 chs. dist., perpetuated and
recorded by James W. Byron, Douglas County Surveyor, in
1959, monumented with an iron post, 1 in. diam., firmly
set, projecting 6 ins. above ground, with brass cap mkd.

COUNTY SURVEYORS OFFICE 1959

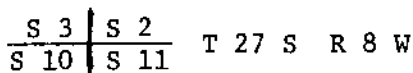

1959

from which the remains of the original bearing trees

A fir, 50 ins. diam., bears N. 43° E., 45 lks.
dist., with scribe marks 8W BT visible on open
blaze.

A fir snag, 44 ins. diam., bears S. 66° E., 84 lks.
dist., with healed blaze.

A cedar stump, 36 ins. diam., bears S. 33° W.,
113 lks. dist., no marks visible.

A fir stump, 48 ins. diam., bears N. 39° W.,
120 lks. dist., no marks visible.

and bearing trees mkd. by Byron

A fir, 12 ins. diam., bears S. 71 1/2° W.,
51 lks. dist., no marks visible.

A fir stump, 10 ins. diam., bears N. 36 1/2° W.,
51 lks. dist.; no marks visible.

No other suitable trees available.

Also, from this same point, the 1/4 sec. cor. of secs. 9
and 10, bears S. 0° 56' E., 39.86 chs. dist., perpetuated
and recorded by John M. Powell, Douglas County Surveyor,
in 1970, monumented with an iron post, 1 in. diam.,
firmly set, projecting 6 ins. above ground, with brass
cap mkd.