

# County Surveyor's Record, Douglas County, Oregon

Survey of Parcel C in Sec. 29,  
T. 20 S., R. 12 W., Willamette Meridian, Oregon

17175

**CHAINS**

N. 48° 49' E., 0.63 chs.

N. 51° 14' E., 1.48 chs.      At end of course, point for Angle Point No. 3 of Parcel D, sec. 29, hereinafter described.

N. 63° 41' E., 1.36 chs.

N. 27° 28' E., 2.00 chs.      At end of course, Angle Point No. 3 of Parcel C, identical with Angle Point No. 2 of Parcel B, hereinbefore described.

-----

Thence N. 85° 37' W., on line 3-4 of Parcel C, identical with line 2-1 of Parcel B.

6.264      Angle Point No. 4 of Parcel C, identical with Angle Point No. 1 of Parcel B.

-----

Thence S. 4° 23' W., on line 4-1 of Parcel C, along the 40 ft. easterly right-of-way of U.S. Highway No. 101.

7.912      Angle Point No. 1 of Parcel C, and point of beginning.

Survey of Parcel D in Section 29,  
T. 20 S., R. 12 W., Willamette Meridian, Oregon

Beginning at Angle Point No. 1 of Parcel D, identical with Angle Point No. 2 of Parcel C, hereinbefore described.

Thence S. 85° 37' E., on line 1-2 of Parcel D, in Tahkenitch Lake.


1.515      Point for Angle Point No. 2 of Parcel D, at deed distance, is located in Tahkenitch Lake, where it is impracticable to establish a permanent monument.

-----

Thence N. 30° 00' E., on line 2-3 of Parcel D, in Tahkenitch Lake along the westerly shore.

5.96      Intersect line 2-3 of Parcel C, point for Angle Point No. 3 of Parcel D, at deed distance, on the high water line on W. shore of Tahkenitch Lake.

Set an aluminum post, 28 ins. long, 2 1/2 ins. diam., 24 ins. in the ground, with aluminum cap mkd.

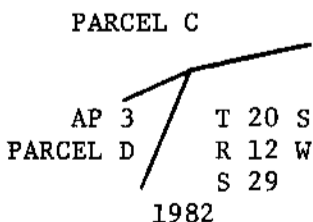

Set a steel fence post alongside aluminum post.