

County Surveyor's Record, Douglas County, Oregon


17177

Survey of Parcel E, Section 20,
T. 20 S., R. 12 W., Willamette Meridian, Oregon

CHAINS
13.495

Intersect the 110 ft. easterly right-of-way of U.S. Highway No. 101, and point for Angle Point No. 2 of Parcel E, identical with Angle Point No. 6 of Parcel F.

Set an aluminum post, 28 ins. long, 2 1/2 ins. diam., 24 ins. in the ground, with aluminum cap mkd.

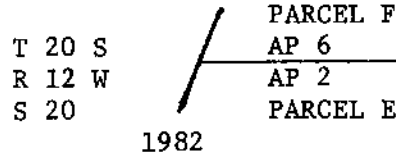

from which

A spruce, 10 ins. diam., bears S. 4° W., 25 1/2 lks. dist., mkd. AP2 PAR E BT.

Set a steel fence post alongside aluminum post.


Thence southerly along the 110 ft. easterly right-of-way of U.S. Highway No. 101, on an 8.389° circular curve to the right, an arc distance of 3.501 chs. (231.04 ft.), the long chord of which bears S. 25° 45' W., 3.484 chs. (229.95 ft.) dist., to a point on the 110 ft. easterly right-of-way of U.S. Highway No. 101.

Thence N. 54° 34' W., 0.909 chs. dist., to a point on the 50 ft. easterly right-of-way of U.S. Highway No. 101.

Thence southwesterly along the 50 ft. easterly right-of-way of U.S. Highway No. 101, on a 9.197° circular curve to the right, an arc distance of 2.260 chs. (149.14 ft.), the long chord of which bears S. 42° 18' W., 2.254 chs. (148.78 ft.) dist., to a point of curve on the 50 ft. easterly right-of-way of U.S. Highway No. 101.

Thence S. 49° 09' W., on a tangent along the 50 ft. easterly right-of-way of U.S. Highway No. 101, a distance of 3.996 chs. (263.7 ft.), to the point of intersection with the N. and S. center line of the NE 1/4 of sec. 20, and point for Angle Point No. 3 of Parcel E.

Set an aluminum post, 28 ins. long, 2 1/2 ins. diam., 24 ins. in the ground, with aluminum cap mkd.

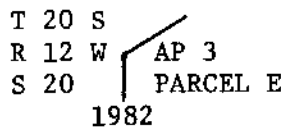

from which

A fir, 6 ins. diam., bears N. 9 3/4° E., 40 lks. dist., mkd. AP S20 BT.

Set a steel fence post alongside aluminum post.

Thence S. 0° 27' E., on line 3-4 of Parcel E on the N. and S. center line of the NE 1/4 of sec. 20.

2.02

The NE 1/16 sec. cor. of sec. 29.