22272
OFFICIALLY FILED: 5/4/2011
THERE ARE NO LINE NOTES TO GO WITH THIS RETRACEMENT - ALL OF THE AVAILABLE INFORMATION IS ON THIS PLAT

FILED
Date: 5/17/2011 By: JC
This survey consists of:
Map: T28S R8W 2011-1
~~Narrative:~~ VOL 56
~~Corner Rpt:~~ PGS 22272-73
DOUGLAS COUNTY SURVEYOR

TOWNSHIP 28 SOUTH, RANGE 8 WEST, OF THE WILLAMETTE MERIDIAN, OREGON

SHEET 1 OF 2

RETRACEMENT

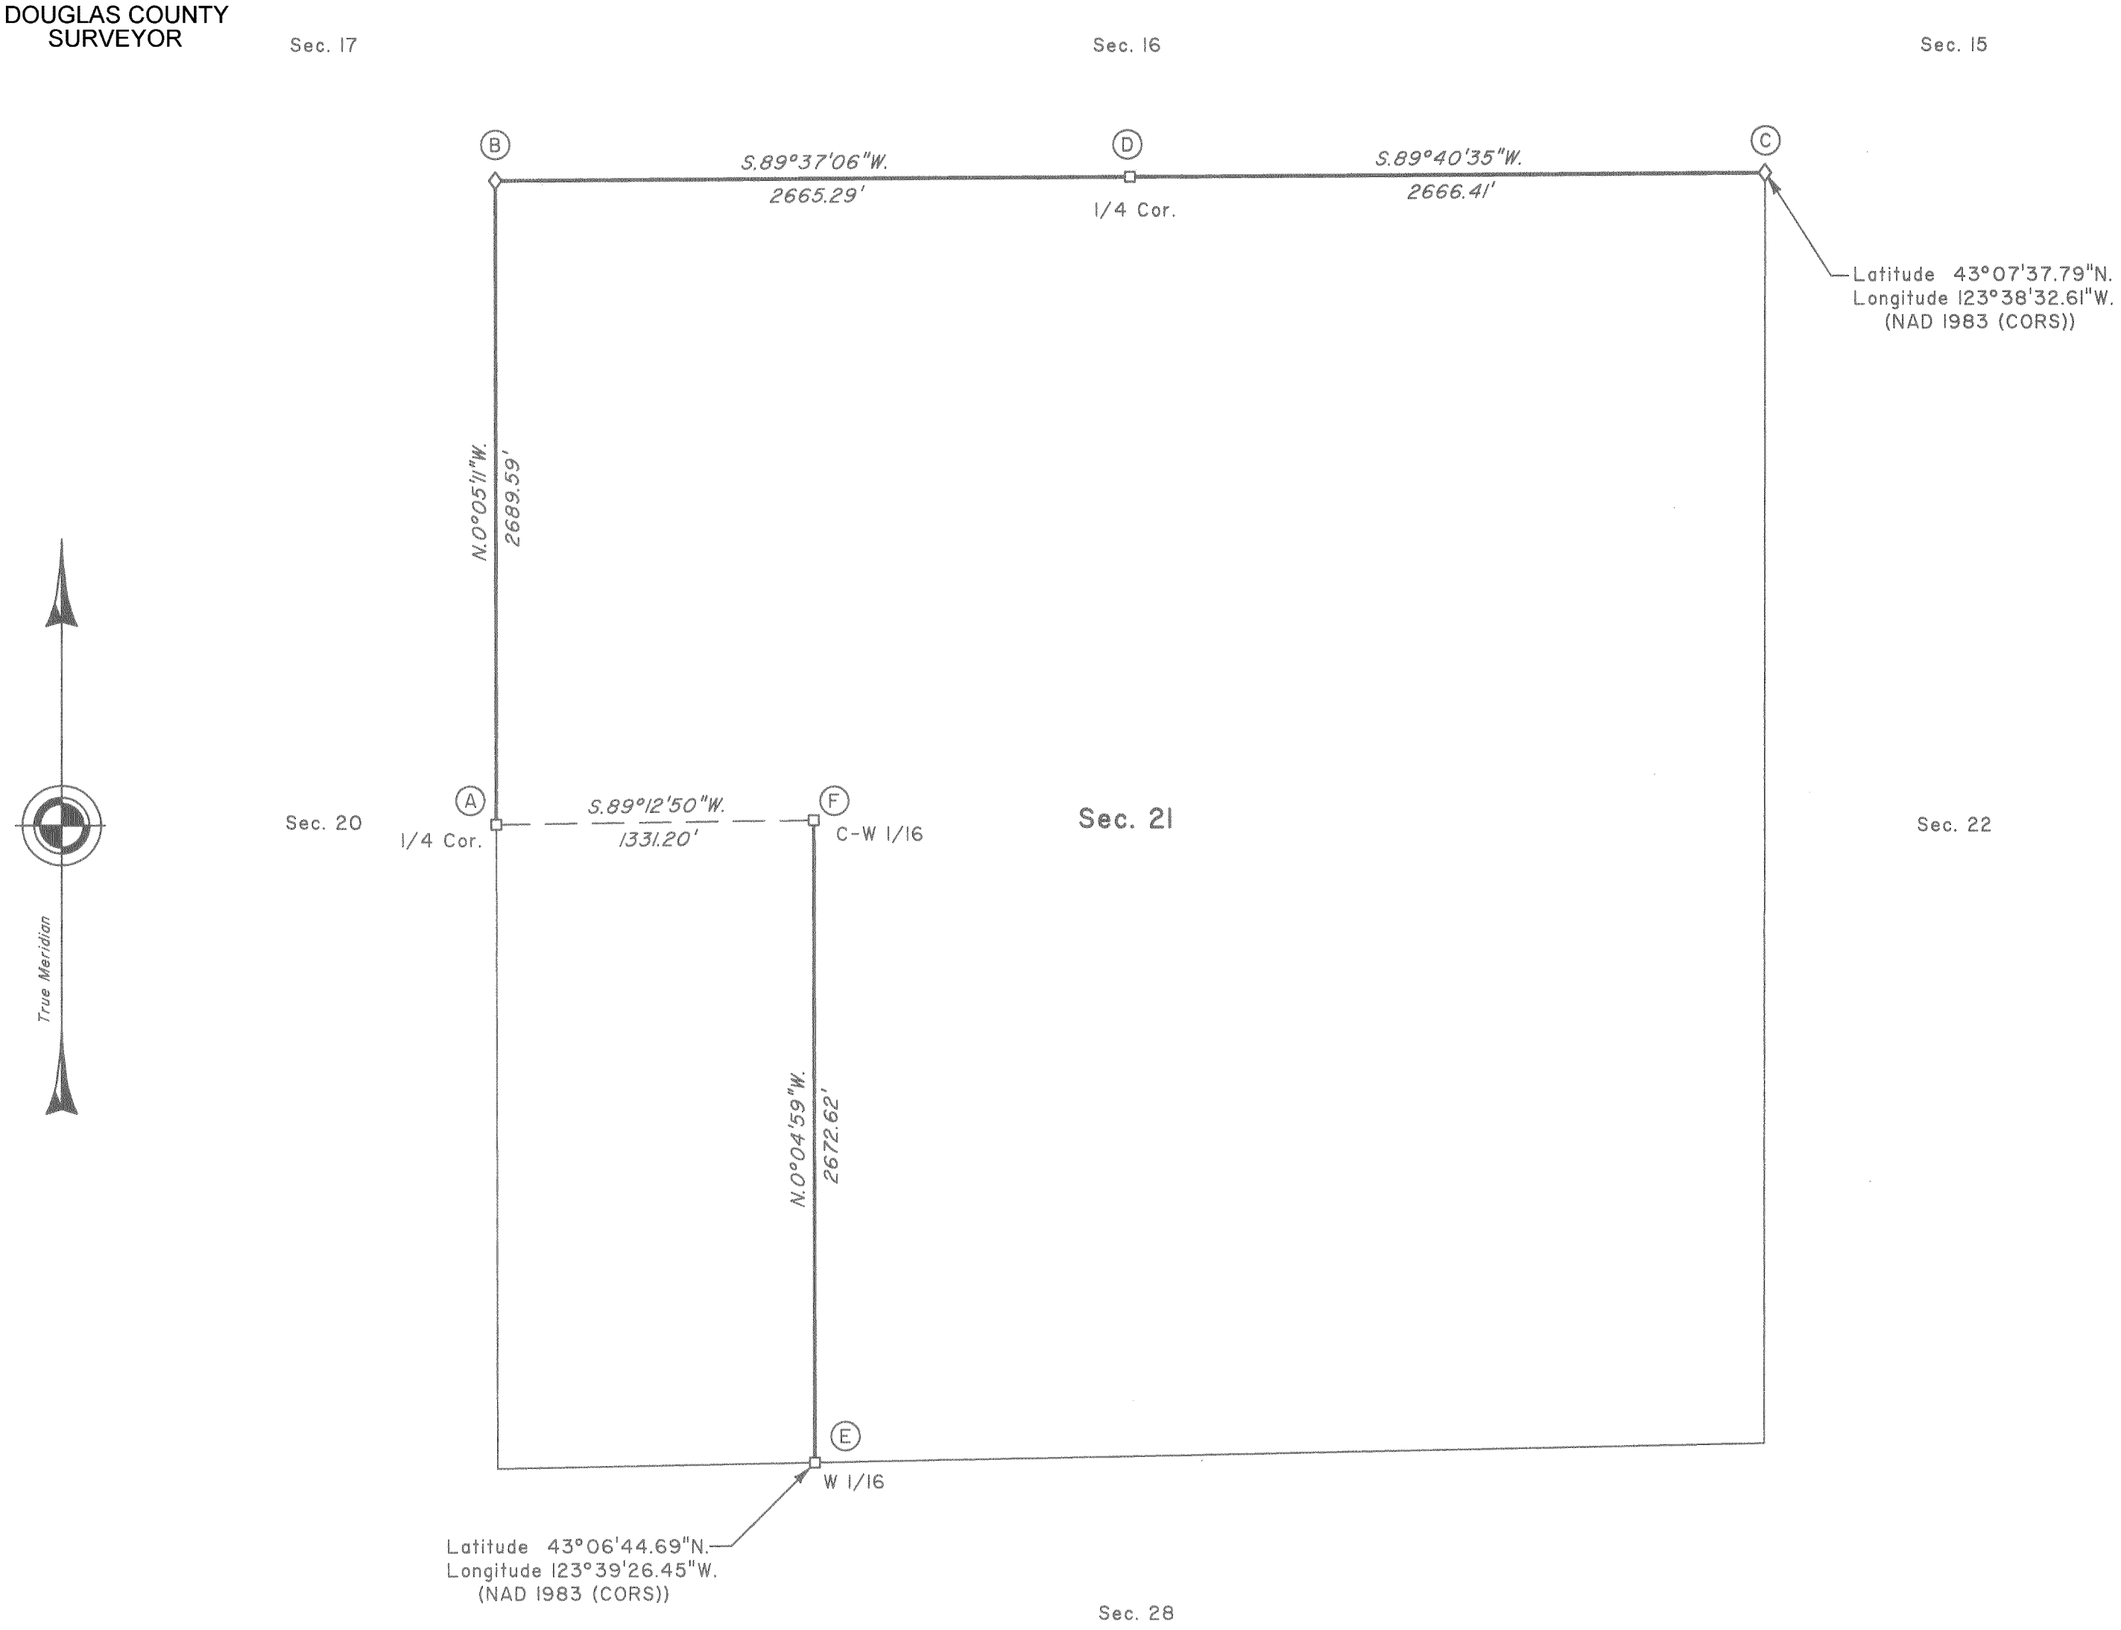

This plat represents the entire record of the retracement of a portion of the subdivisional lines and subdivision-of-section lines of section 21, T. 28 S., R. 8 W., Willamette Meridian, Oregon.

A history of surveys pertaining to this retracement is as follows on Sheet 2 of 2.

The direction of the lines are based on the true meridian as determined by a combination of direct solar observations and Global Positioning System (GPS) measurements.

The retracement data were thoroughly verified and only the true line data are given hereon. Only those lines bounding or crossing public lands were blazed.

An analysis of the unadjusted field data assured a closure not exceeding 1:4000 in error. Measured distances and directions have been adjusted by computer software that incorporates a least squares adjustment routine. The adjusted bearings and distances are reported to the nearest second and 0.01 foot.

The lottings and areas are as shown on the plat approved July 7, 1856, December 17, 1875, and January 10, 1876.

The geodetic positions shown hereon for the corner of sections 15, 16, 21, and 22, and the W 1/16 section corner of sections 21 and 28 were determined by a tie from a temporary control point established utilizing dual frequency, carrier phase GPS receivers relative to the National Spatial Reference System.

Each new bearing tree has a 2 1/2 inch x 1/4 inch magnetic nail (Mag Nail) driven at the base on right side center, unless otherwise noted in the corner description.

This survey was executed by Kenneth W. Saveland, Cadastral Surveyor, beginning September 9, 2009, and completed October 6, 2009, in accordance with the specification set forth in the Manual of Surveying Instructions, 1973; pursuant to Special Instructions dated March 16, 2007, approved March 21, 2007, which provided for the survey included under Group Number 2300, Administrative File Number 0905, and Assignment Instructions dated September 2, 2009. He was assisted by Robert NMI Durning, Joel R. Herzberg, and Thomas A. Hollamon, Surveying Technicians.

LEGEND

◇ Original corner previously remonumented
□ Corner previously established or reestablished

I, Kenneth W. Saveland, Cadastral Surveyor, HEREBY CERTIFY upon honor, that in pursuance of Special Instructions bearing date of the 16th day of March, 2007, I have retraced a portion of the subdivisional lines and subdivision-of-section lines of section 21, Township 28 South, Range 8 West, Willamette Meridian, Oregon, which is represented upon this plat as having been executed by me and under my direction. Said retracement has been made in strict conformity with said Special Instructions, the Manual of Instructions for the Survey of the Public Lands of the United States, 1973, and in specific manner described upon this plat.

Kenneth W. Saveland
Cadastral Surveyor

FEBRUARY 22, 2011
Date

UNITED STATES DEPARTMENT OF THE INTERIOR
BUREAU OF LAND MANAGEMENT

Portland, Oregon

The retracement represented by this plat, having been correctly executed in accordance with the requirements of law and the regulations of this Bureau, is hereby accepted.

For the Director

John P. Tannsworth, Acting
Chief Cadastral Surveyor of Oregon

March 2, 2011
Date

600 300 0 600 1200 1800 2400 3000 3600 4200 4800
Scale in Feet

JT