


# TOWNSHIP N° 19 SOUTH, RANGE N° 7 WEST, OF THE WILLAMETTE MERIDIAN, OREGON.

DEPENDENT RESURVEY

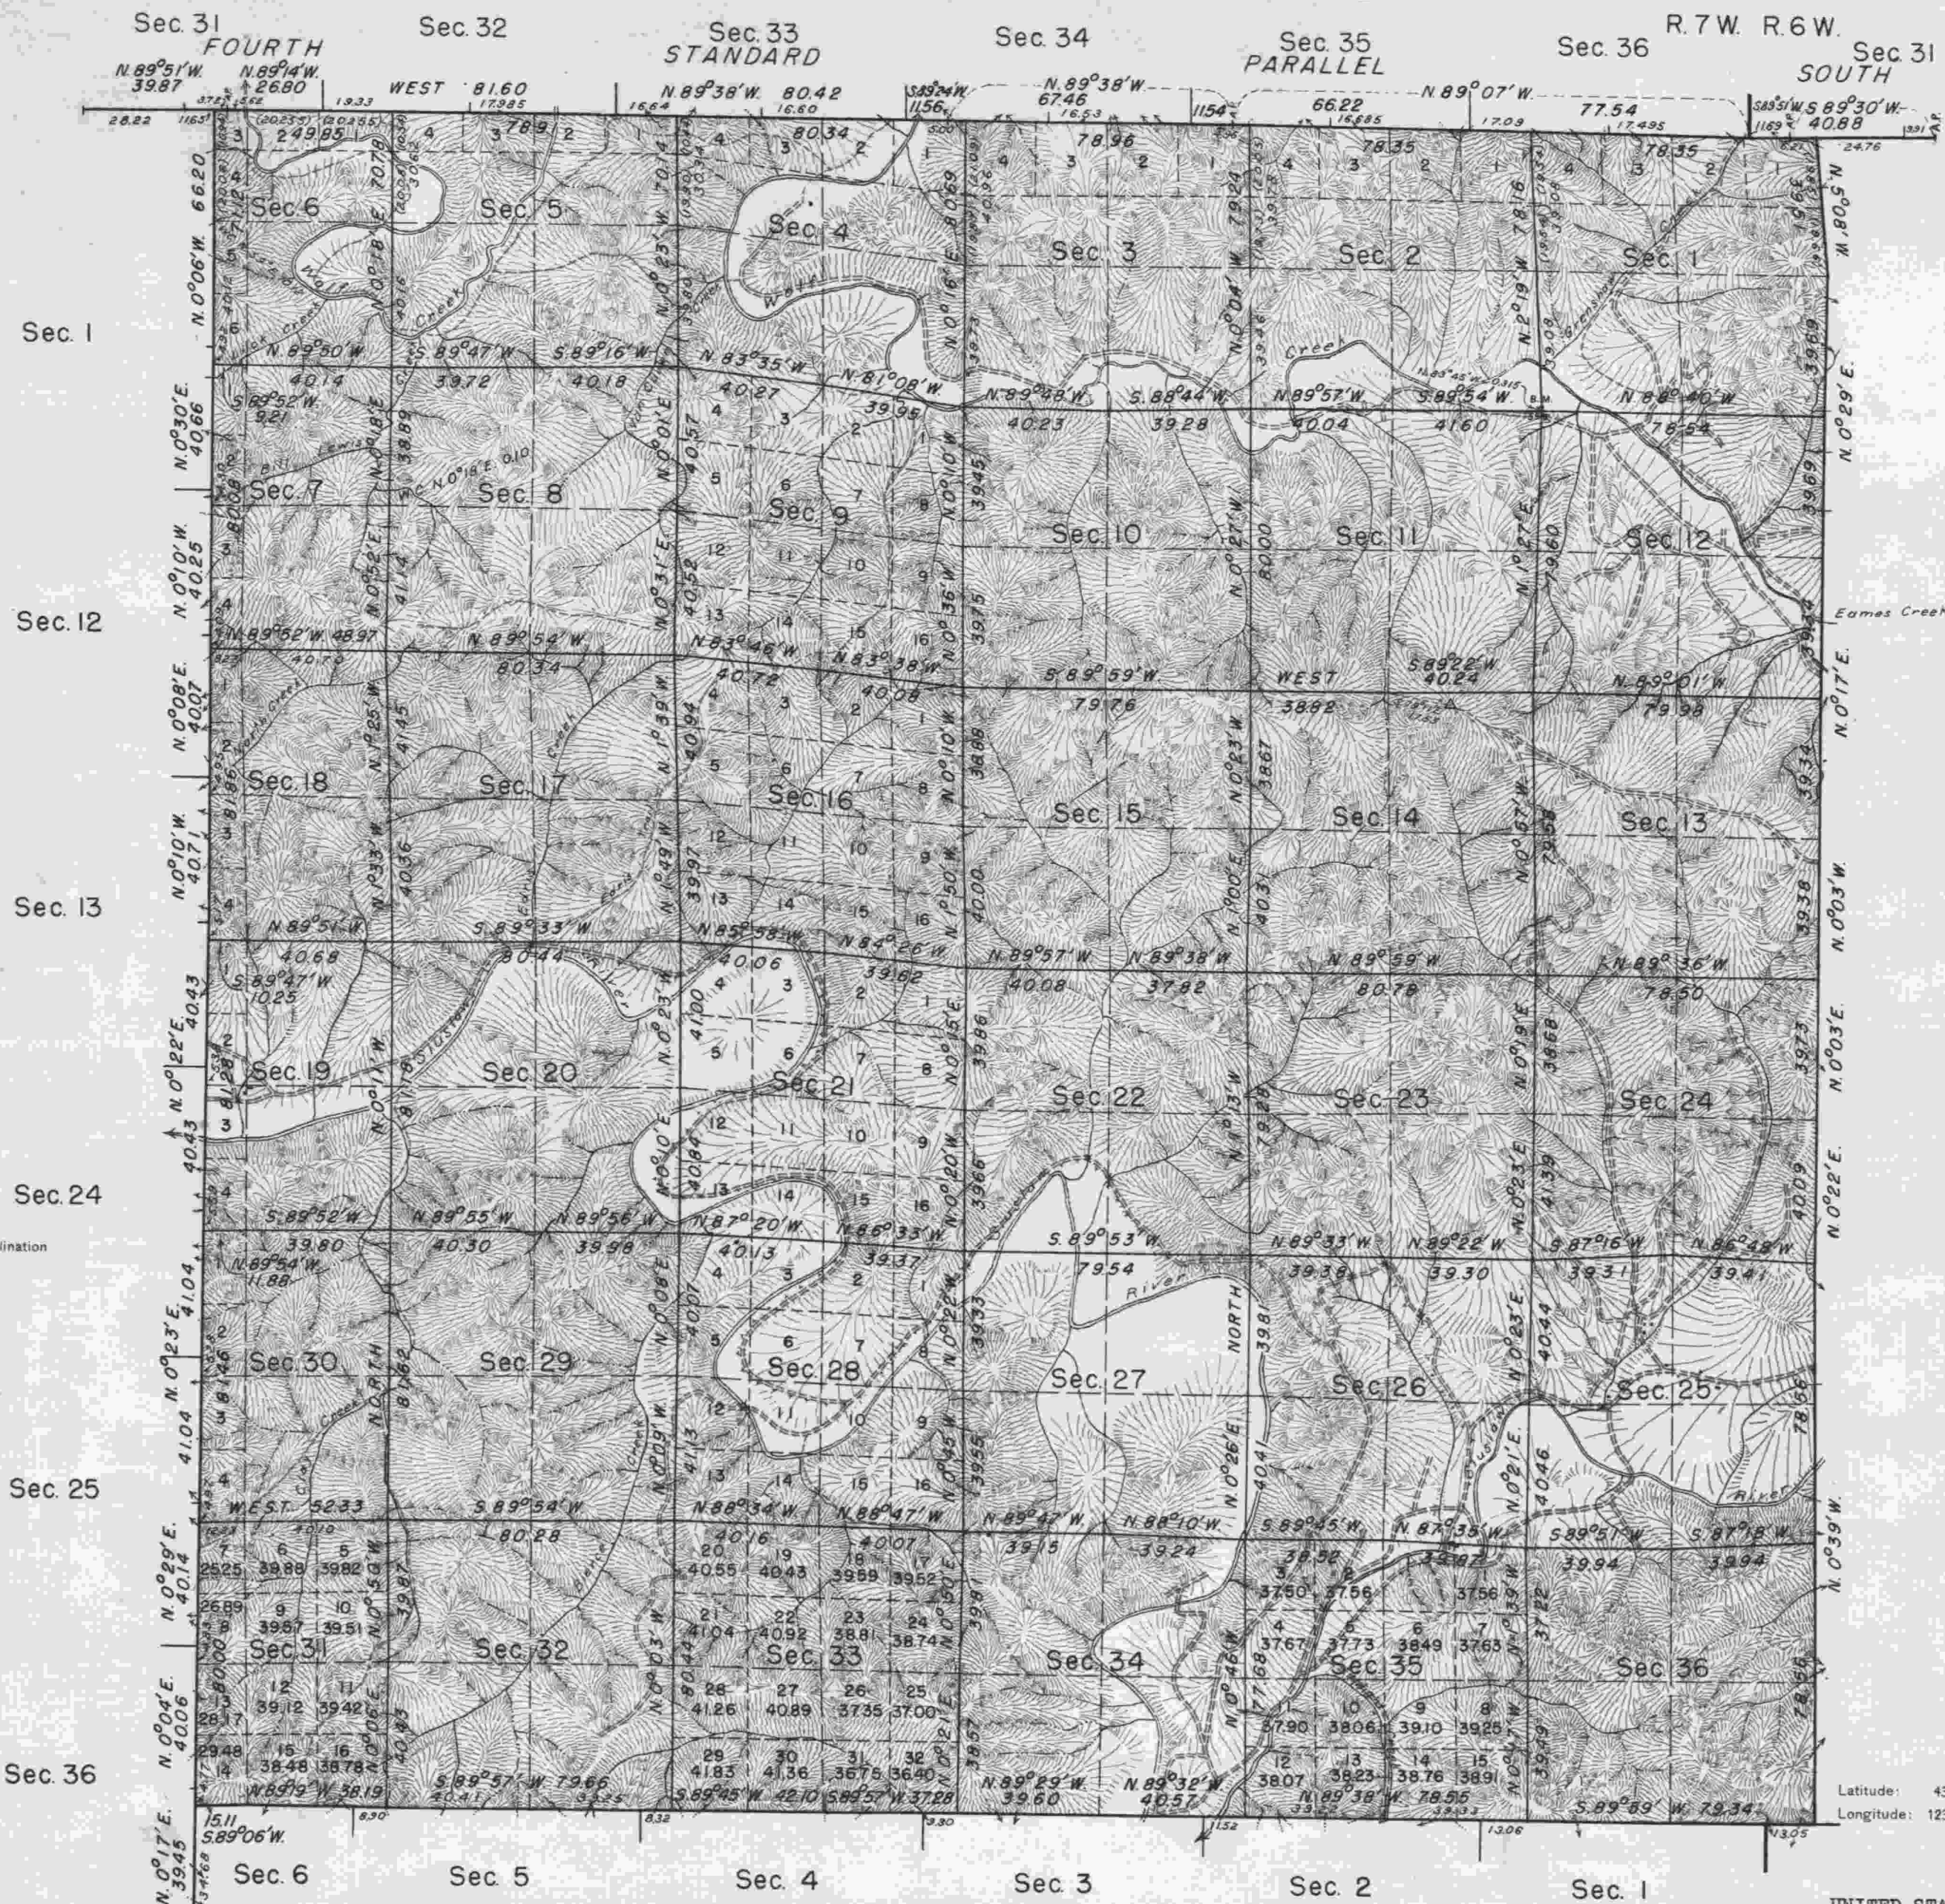

This plat represents a retracement and re-establishment of the original township boundary and subdivisinal lines designed to restore the corners in their original locations according to the best available evidence. The lottings and areas are as shown on the plats approved October 16, 1874 and April 4, 1892, except as new areas are shown hereon.


This township is heavily timbered with Douglas fir, western hemlock, red cedar, Oregon maple, alder and chinquapin, the Douglas fir predominating. Ash and white fir grow only on bottom land along the larger streams. Madrona, yew, dogwood, cherry and casahuate are scattering over the region.

Latitude: 43° 52' 06" N.  
Longitude: 123° 27' 56" W.

North boundary resurveyed by Norman D. Price in 1947.

Area Resurveyed: 21,404.67 Acres

Resurvey of the south and east boundaries and subdivisinal lines of T. 19 S., R. 7 W., and the east boundary of T. 19 S., R. 8 W., executed by Norman D. Price and Thomas A. Tillman June 16 to September 23, 1949 under Special Instructions for Group 284, Oregon, dated June 21, 1946.

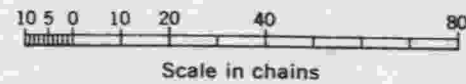

UNITED STATES DEPARTMENT OF THE INTERIOR  
BUREAU OF LAND MANAGEMENT  
Washington, D. C., May 16, 1951  
This plat is strictly conformable to the approved field notes, and the survey, having been correctly executed in accordance with the requirements of law and the regulations of this Bureau, is hereby accepted.

For the Director  
*William F. Richards*  
Chief, Branch of Surveys