1242 Township No. 19 South Range No. 9 West of the Willamette Meridian Oregon

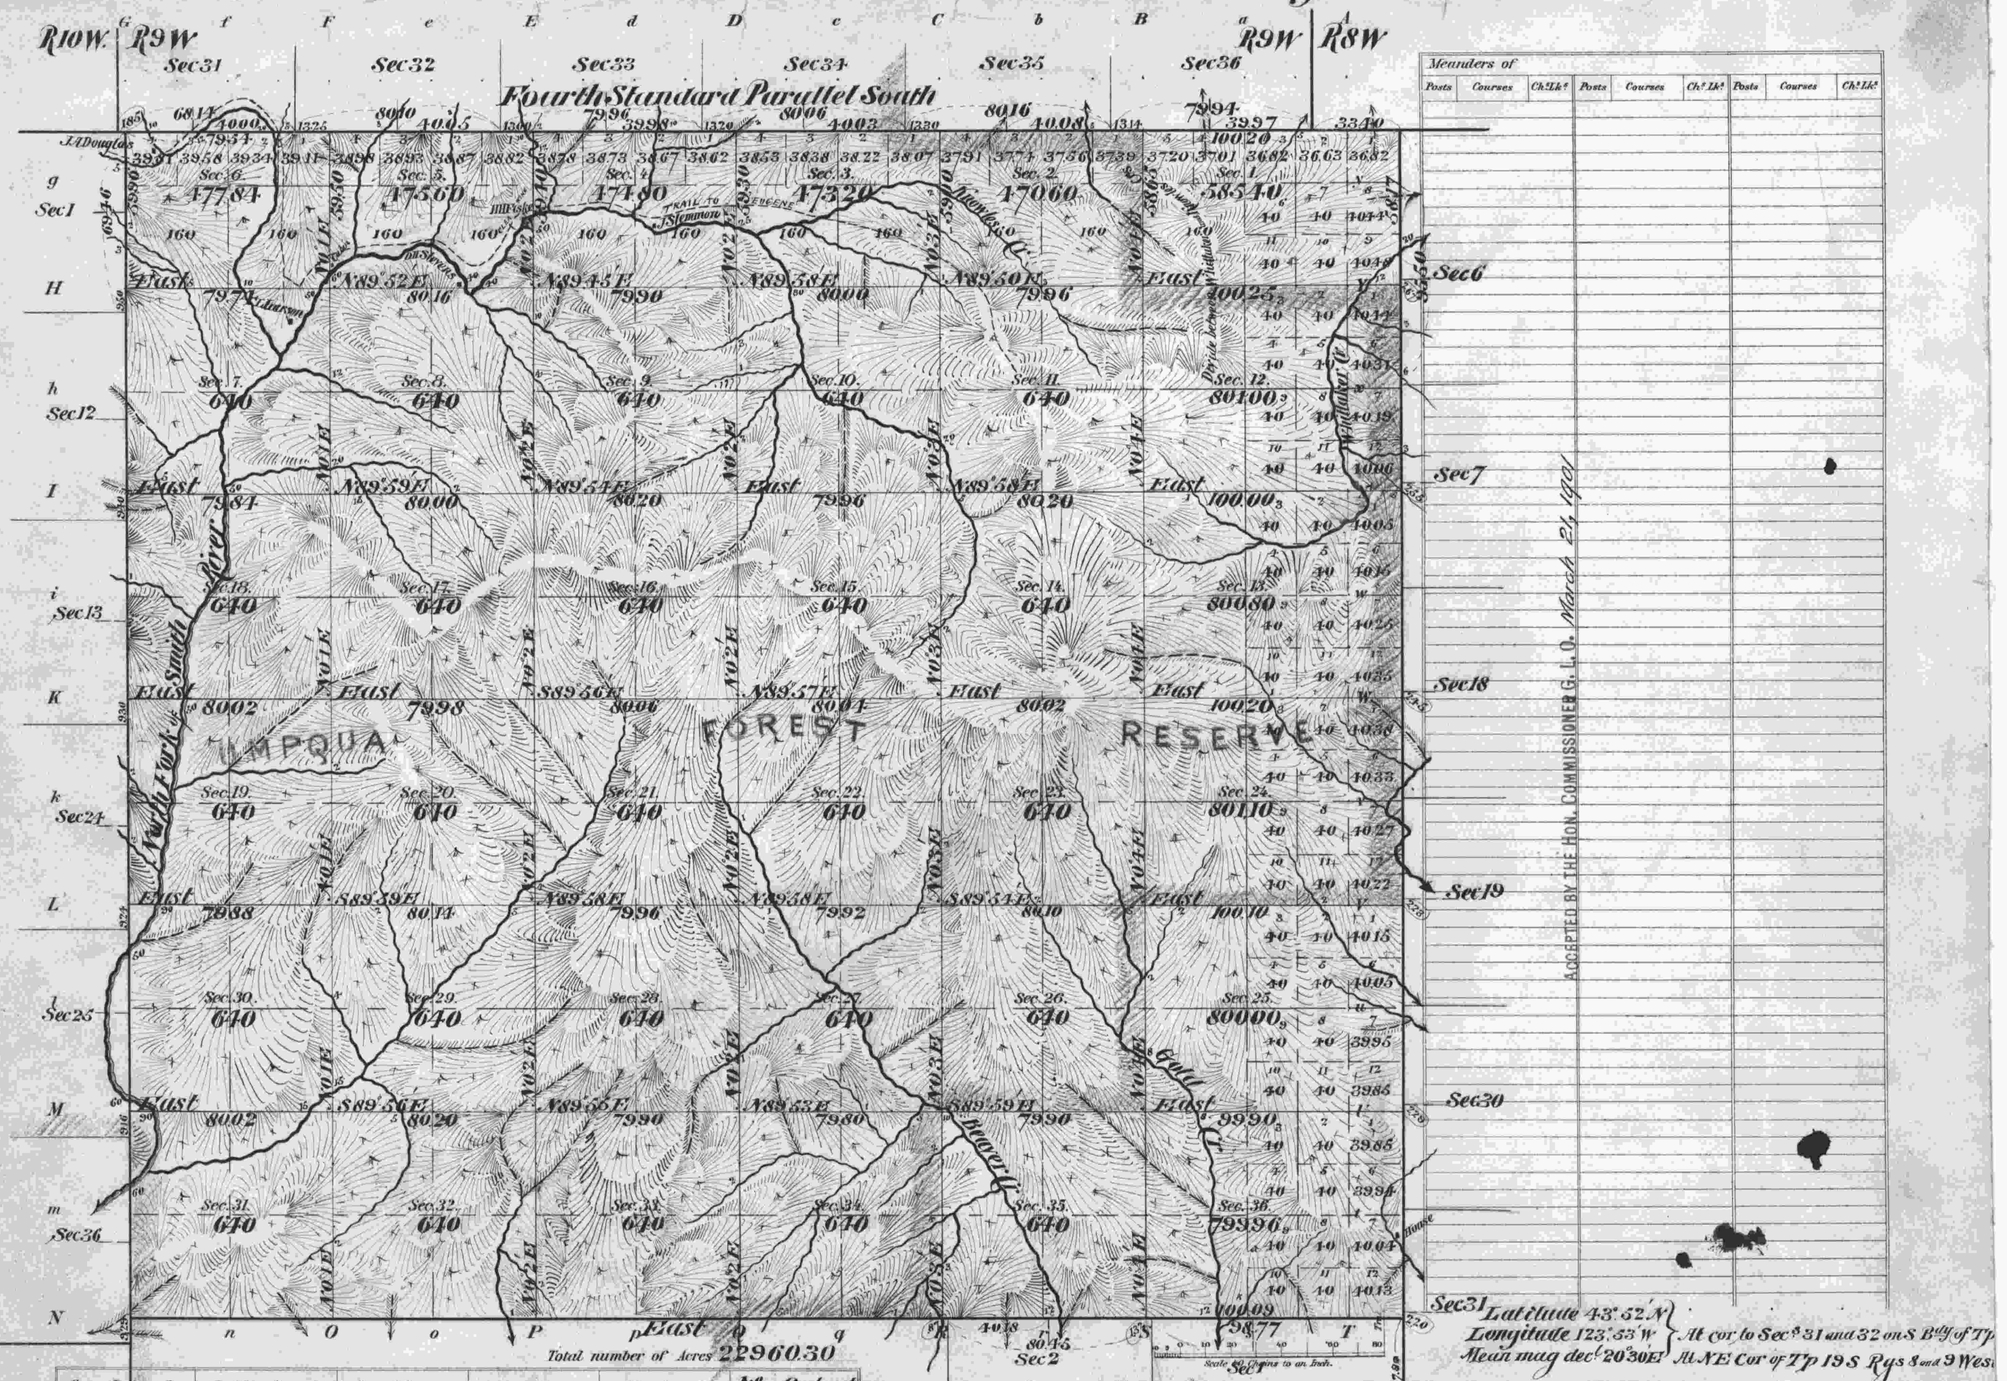

Surveys Designated.	By Whom Surveyed.	Date of Contract	Amount of Surveys M. Ch. Lk.	When Surveyed.	No. of Contract
Township lines West and part of S. Bdries	Henry L. Chandler	April 14 1899			705
Subdivisions	" " "	" " "	59 - 76 - 20	Aug 12 to Sept 7 1899	"
Resurvey of N. Bdy. of 1st Std. Par. S.	" " "	" " "			"
" of S. Bdy. of Sec. 35 & 36	" " "	" " "	1 44 . 68		"
Connections Original Survey of 4th Std. Par. South	H. Gordon & C. P. Gardner			1855	53
East Bdry	C. M. Collier			1891	580

The above Map of Township No. 19 South of Range No. 9 West of the Willamette Meridian Oregon is strictly conformable to the field notes of the survey thereof on file in this Office, which have been examined and approved.

Surveyor General's Office, Portland Oregon Feb 12. 1901

Robert A. Habersham
Sur. Gen. for Oregon