Township No. 20 South, Range No. 5 West of the Willamette Meridian, Oregon.

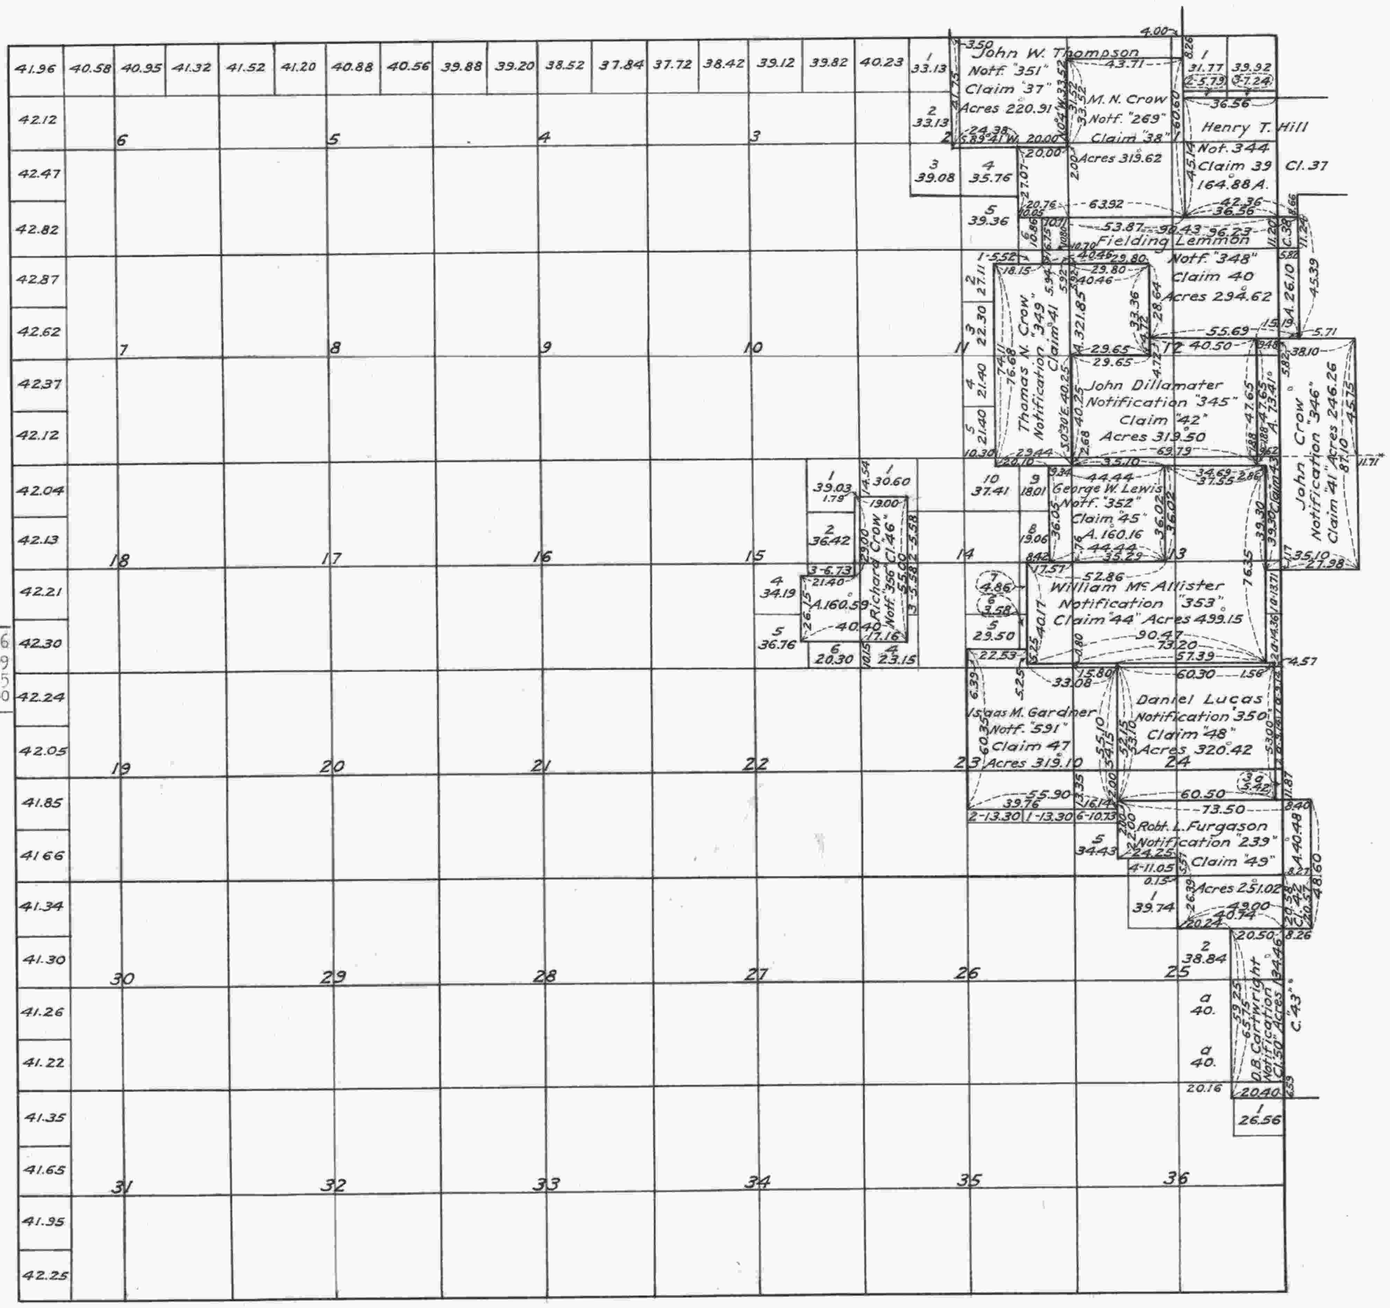

Aggregate area of Public Lands	19530.16
Private Surveys	3559.69
Deduct error in computations	5.85
Total return on Township Plat	23084.00

The above Map of claims in Township No.20 South, Range No.5 West, Willamette Meridian, Oregon, is strictly conformable to the field notes of the survey thereof on file in this Office, which have been examined and approved.
Surveyor General's Office,
Eugene City, December 23rd, 1859. (signed) W. W. Chapman.
Sur Gen'l. of Oregon.

I certify this to be a correct copy of the original plat on file in this office.
Office of District Cadastral Engineer,
Portland, Oregon, October 31, 1925.

E. P. Rands
District Cadastral Engineer.

B.L.F.