TOWNSHIP 20 SOUTH, RANGE 6 WEST, OF THE WILLAMETTE MERIDIAN, OREGON

DEPENDENT RESURVEY

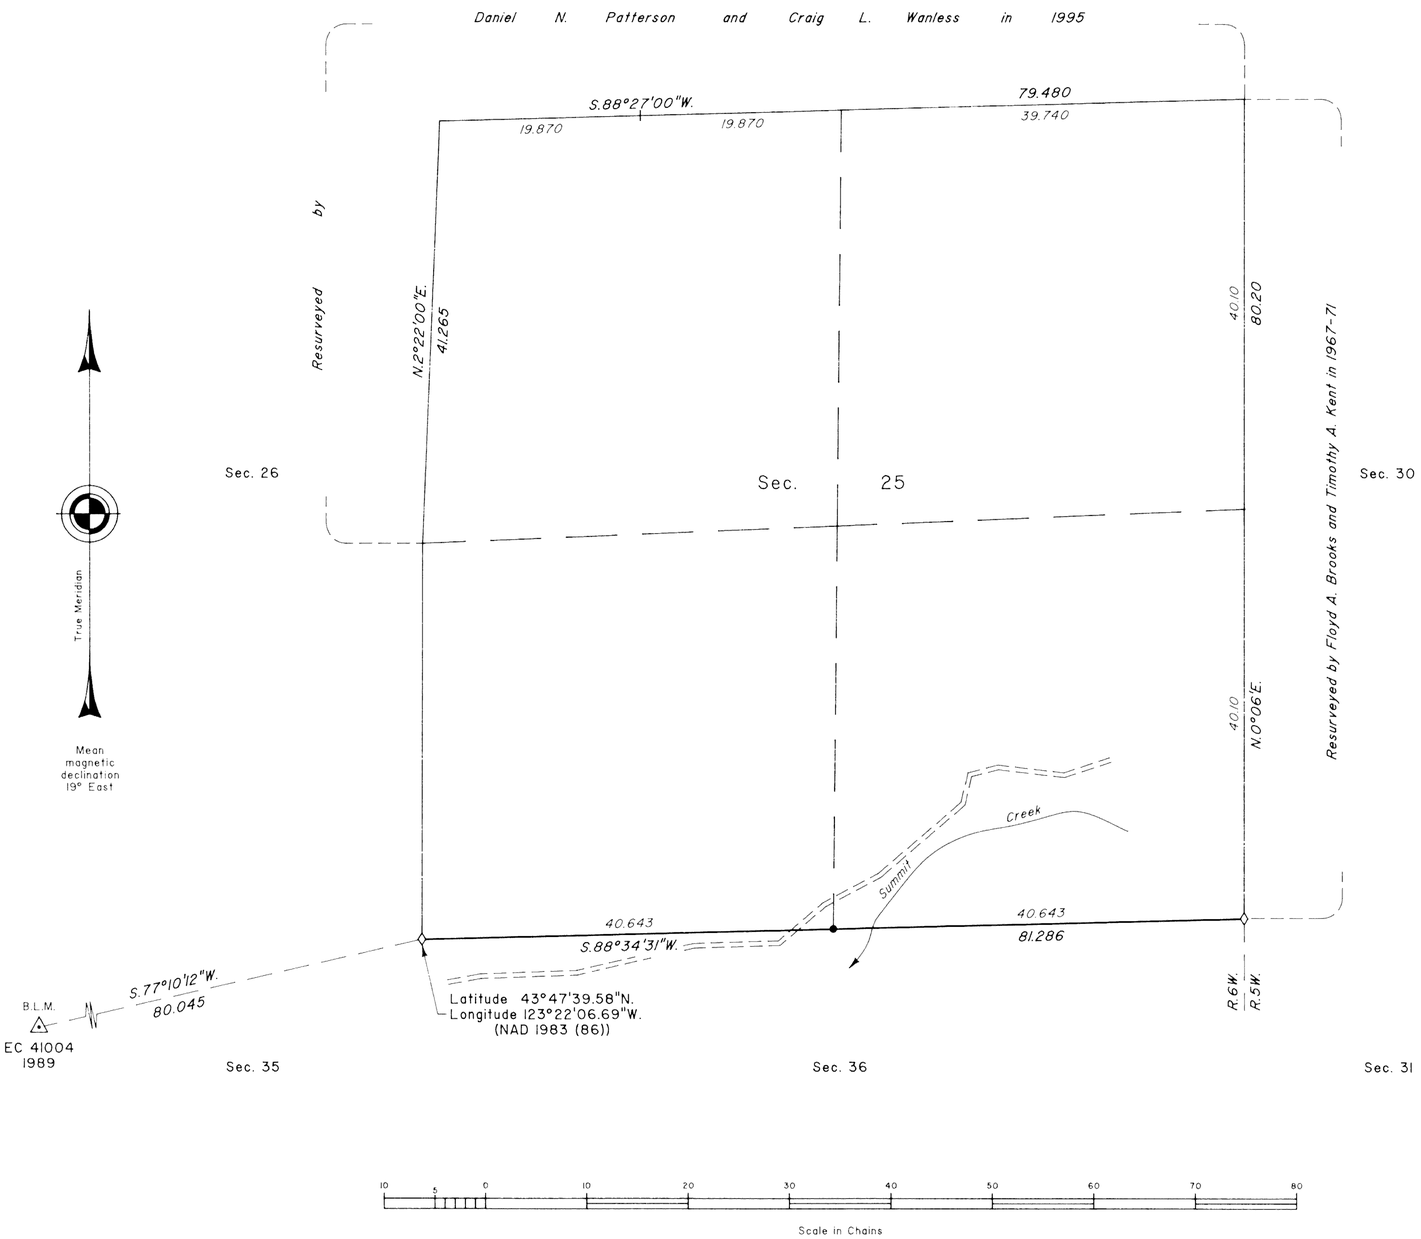

A history of surveys is contained in the field notes.

This plat represents a dependent resurvey of the line between sections 25 and 36, T. 20 S., R. 6 W., Willamette Meridian, Oregon, designed to restore the corners in their true original locations according to the best available evidence.

Measured distances and directions have been adjusted by Cadastral Measurement Management (CMM), a computer program that incorporates a least squares adjustment routine. The adjusted bearings and distances are reported to the nearest second and 0.001 chain.

The lottings and areas are as shown on the plat approved January 23, 1873.

The survey was executed by Wayne L. Rogers, Cadastral Surveyor, beginning May 12, 1997, and completed May 28, 1997, pursuant to Special Instructions dated May 8, 1997, under Group Number 1839, Oregon.

Timber in this area consists of fir, cedar, hemlock, yew, alder, maple, and madrone.

The tie to the geodetic control station is reported as mean bearing and sea level distance.

LEGEND

◇ Original corner previously remonumented

● Corner established or reestablished this survey

UNITED STATES DEPARTMENT OF THE INTERIOR
BUREAU OF LAND MANAGEMENT

Portland, Oregon July 1, 1999

This plat is strictly conformable to the approved field notes, and the survey, having been correctly executed in accordance with the requirements of law and the regulations of this Bureau, is hereby accepted.

For the Director

Wayne M. Gardner

Chief Cadastral Surveyor of Oregon

R.H.B.