TOWNSHIP 20 SOUTH, RANGE 6 WEST, OF THE WILLAMETTE MERIDIAN, OREGON

DEPENDENT RESURVEY AND SUBDIVISION OF SECTION 35

FILED
Date: 1/12/2009 By: JC
This survey consists of:
~~Map~~: BLM LINE NOTES
~~Narrative~~: VOL. 55
~~Corner Rpt~~: PAGES 21507-21
DOUGLAS COUNTY SURVEYOR

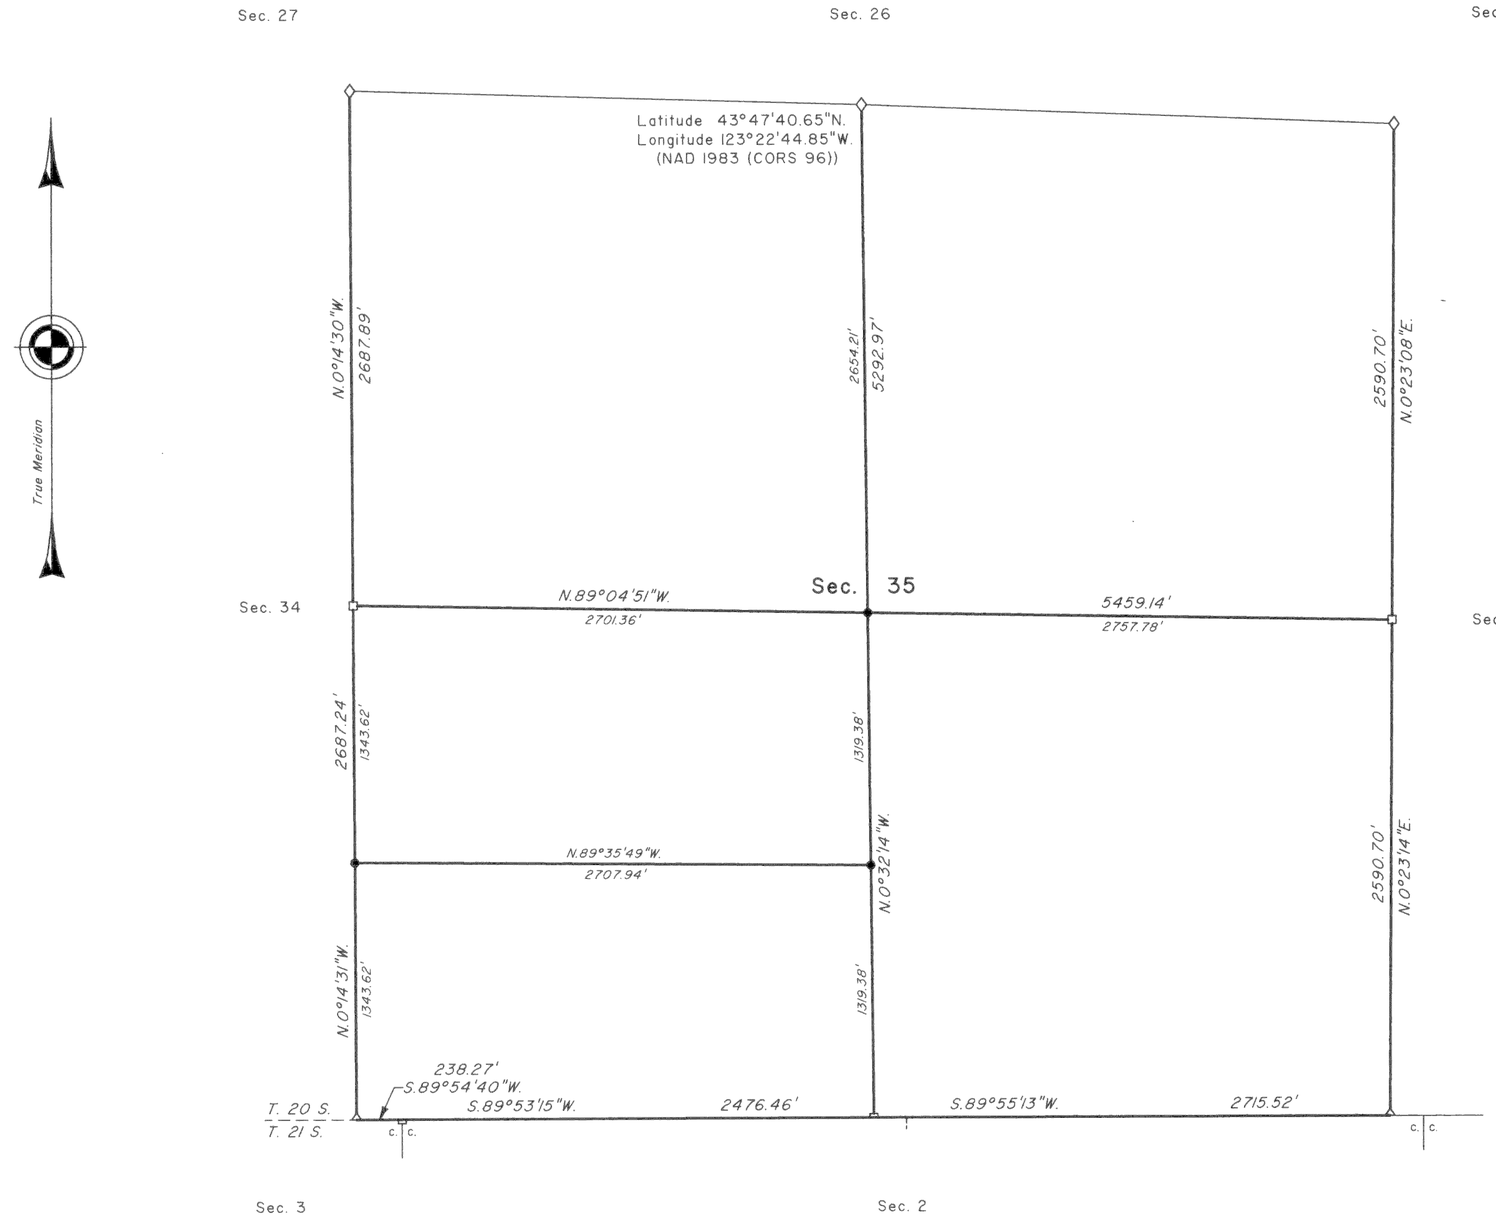

A history of surveys is contained in the field notes.

This plat represents a dependent resurvey of a portion of the portion of the south boundary and subdivisional lines, T. 20 S., R. 6 W., Willamette Meridian, Oregon, designed to restore the corners in their true original locations according to the best available evidence, and the subdivision of section 35.

Measured distances and directions have been adjusted by computer software that incorporates a least squares adjustment routine. The adjusted bearings and distances are reported to the nearest second and 0.01 foot.

The survey was executed by A. Bert Skeesick, Cadastral Surveyor, beginning June 30, 2003, and completed July 29, 2003, pursuant to Special Instructions dated April 14, 2003, under Group Number 2048, Oregon.

Timber in the area consists of fir, cedar, maple, madrone and alder.

LEGEND

- ◇ Original corner previously remonumented
- □ Corner previously established or reestablished
- ● Corner established or reestablished this survey

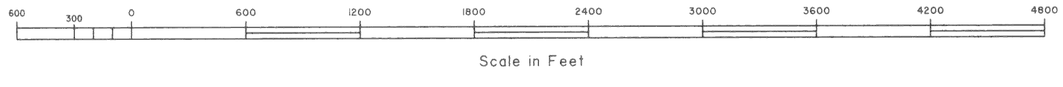

UNITED STATES DEPARTMENT OF THE INTERIOR
BUREAU OF LAND MANAGEMENT

Portland, Oregon

This plat is strictly conformable to the approved field notes, and the survey, having been correctly executed in accordance with the requirements of law and the regulations of this Bureau, is hereby accepted.

For the Director

John P. Farnsworth, Acting

Chief Cadastral Surveyor of Oregon

November 24, 2008

Date

33