ORIGINAL

TOWNSHIP 20 SOUTH, RANGE 6½ WEST, OF THE WILLAMETTE MERIDIAN, OREGON.

DEPENDENT RESURVEY AND SURVEY

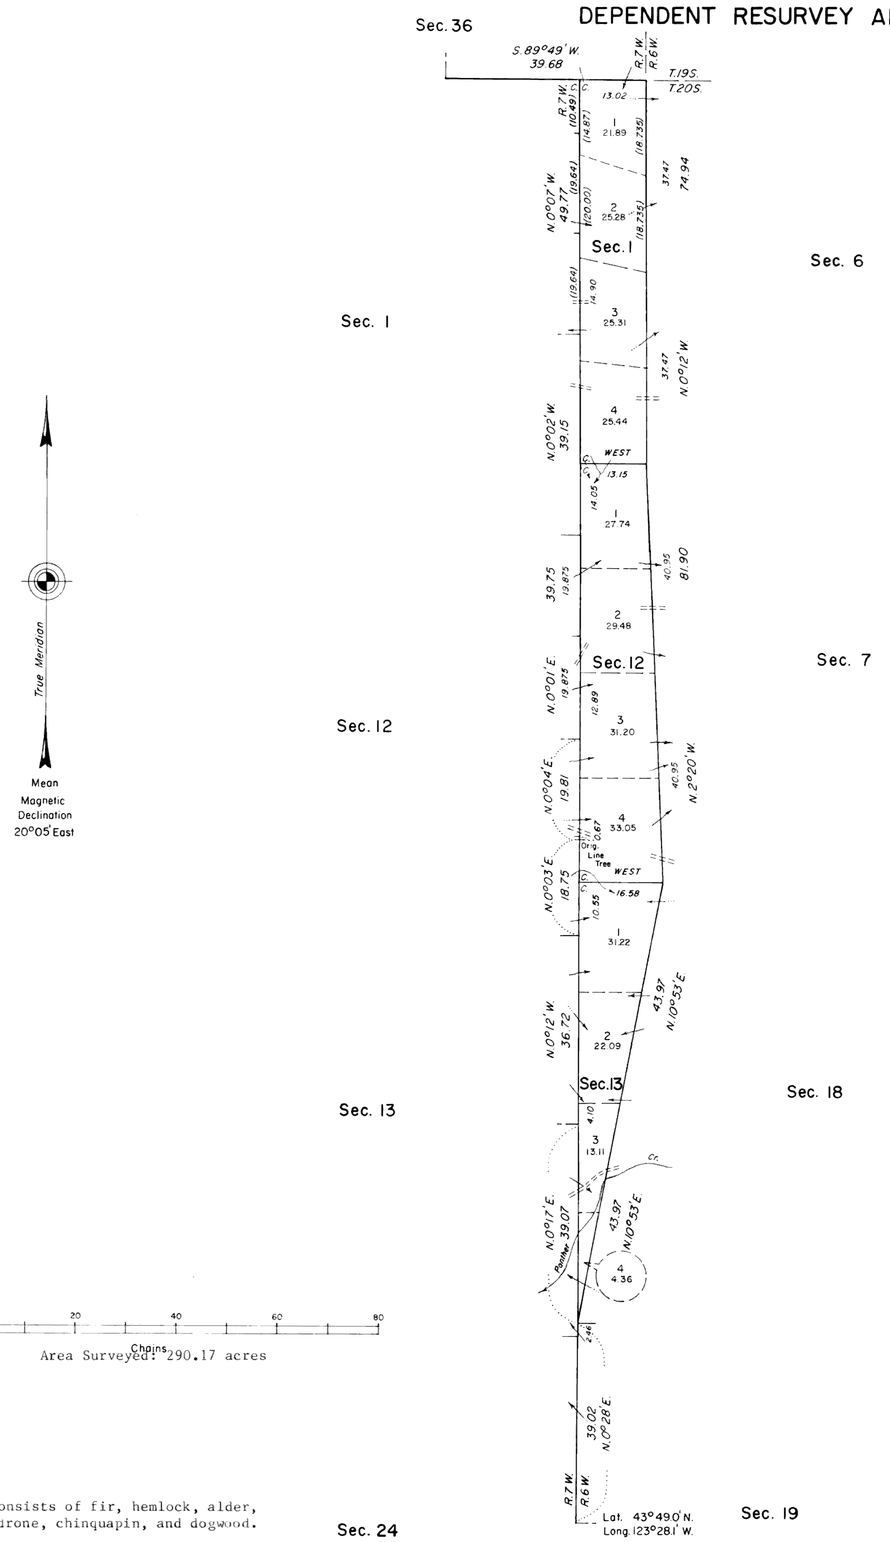

A history of surveys is contained in the field notes.

This plat represents a dependent resurvey of a portion of the west boundary, T. 20 S., R. 6 W.; a portion of the south boundary, T. 19 S., R. 7 W.; and a portion of the east boundary, T. 20 S., R. 7 W., designed to restore the corners in their true original locations according to the best available evidence, and the survey of the subdivisional lines, T. 20 S., R. 6 ½ W., Willamette Meridian, Oregon.

Survey executed by Harvey E. Wofford and Lester E. Fischer, Cadastral Surveyors, from August 13, 1976, to August 4, 1978, under Special Instructions dated July 29, 1976, and Supplemental Special Instructions dated July 21, 1977, which provided for the surveys included under Group No. 913, Oregon.

UNITED STATES DEPARTMENT OF THE INTERIOR
BUREAU OF LAND MANAGEMENT
Denver, Colorado January 28, 1980

This plat is strictly conformable to the approved field notes, and the survey, having been correctly executed in accordance with the requirements of law and the regulations of this Bureau, is hereby accepted.

For the Director

Chief, Cadastral Survey
Examination and Approval Staff

Timber in this area consists of fir, hemlock, alder, maple, cedar, yew, madrone, chinquapin, and dogwood.

R.T.S.