ORIGINAL

TOWNSHIP 20 SOUTH, RANGE 7 WEST, OF THE WILLAMETTE MERIDIAN, OREGON.

DEPENDENT RESURVEY AND REMONUMENTATION

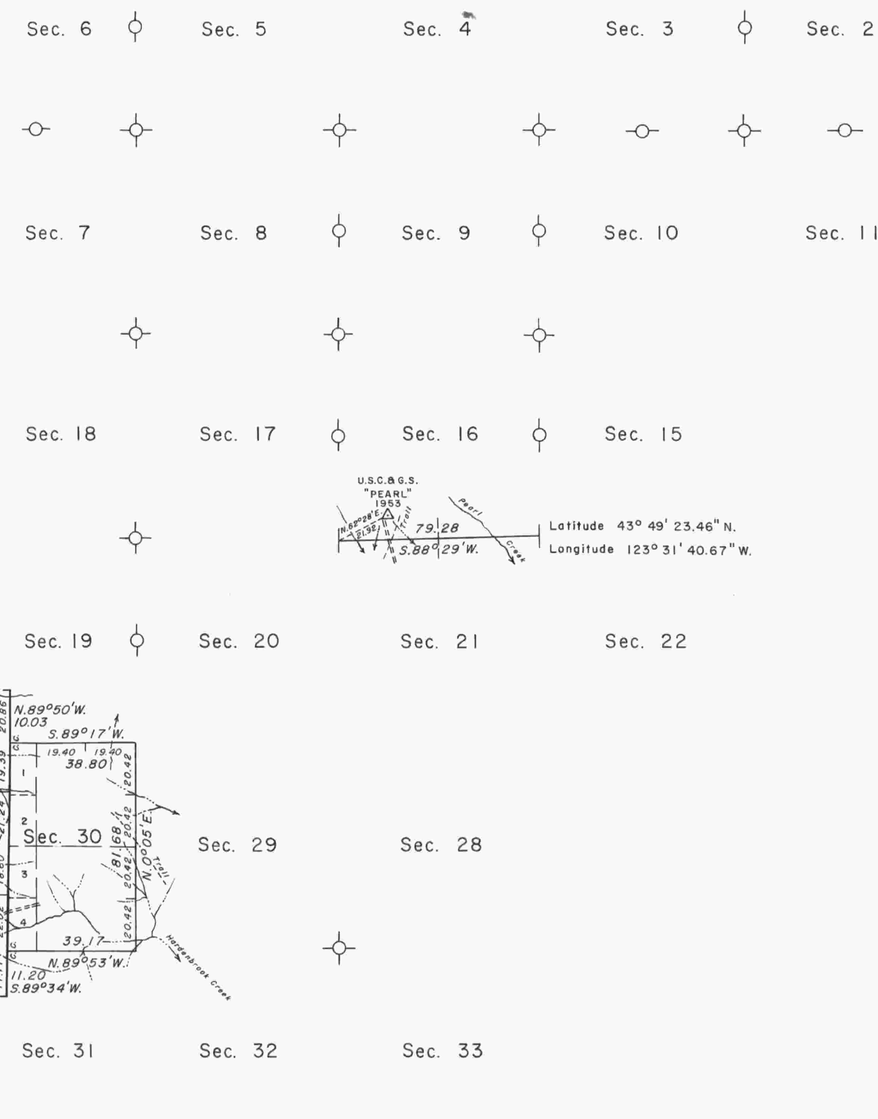

This plat represents a retracement and reestablishment of a portion of the east boundary of T. 20 S., R. 8 W., a portion of the subdivisional lines, and remonumentation of certain original corner points in T. 20 S., R. 7 W., Willamette Meridian, Oregon, designed to restore the corners in their true original locations according to the best available evidence.

The lottings and areas are as shown on the plat approved November 9, 1892.

The east boundary of T. 20 S., R. 8 W., was surveyed by William P. Wright in 1884.

The east boundary of T. 20 S., R. 8 W., was retraced and the subdivisional lines of T. 20 S., R. 7 W., were surveyed by Thomas E. Todd in 1891.

The east boundary of T. 20 S., R. 8 W., was dependently resurveyed by Thomas A. Tillman in 1950-54.

The resurvey was executed by Lynn M. Roseberry and William W. Glenn, Cadastral Surveyors, October 3, 1966, to May 16, 1967, under Special Instructions dated May 3, 1957, and September 29, 1966, which provide for the surveys included under Group Nos. 350 and 622, Oregon.

⊹ Remonumentation under Group No. 350 in 1966.

Timber in this area consists of fir, hemlock, cedar, maple, alder, yew, dogwood, and chinquapin.

10 5 0 10 20 30 40 50 60 70 80

Chains

Area resurveyed: 406.78 Acres

UNITED STATES DEPARTMENT OF THE INTERIOR
BUREAU OF LAND MANAGEMENT
Washington, D. C. January 19, 1970

This plat is strictly conformable to the approved field notes, and the survey, having been correctly executed in accordance with the requirements of law and the regulations of this Bureau, is hereby accepted.

For the Director

Acting Chief, Division of Cadastral Survey

RJL—5/69