TOWNSHIP 20 SOUTH, RANGE 7 WEST, OF THE WILLAMETTE MERIDIAN, OREGON

DEPENDENT RESURVEY AND SUBDIVISION OF SECTIONS 14, 23, AND 35

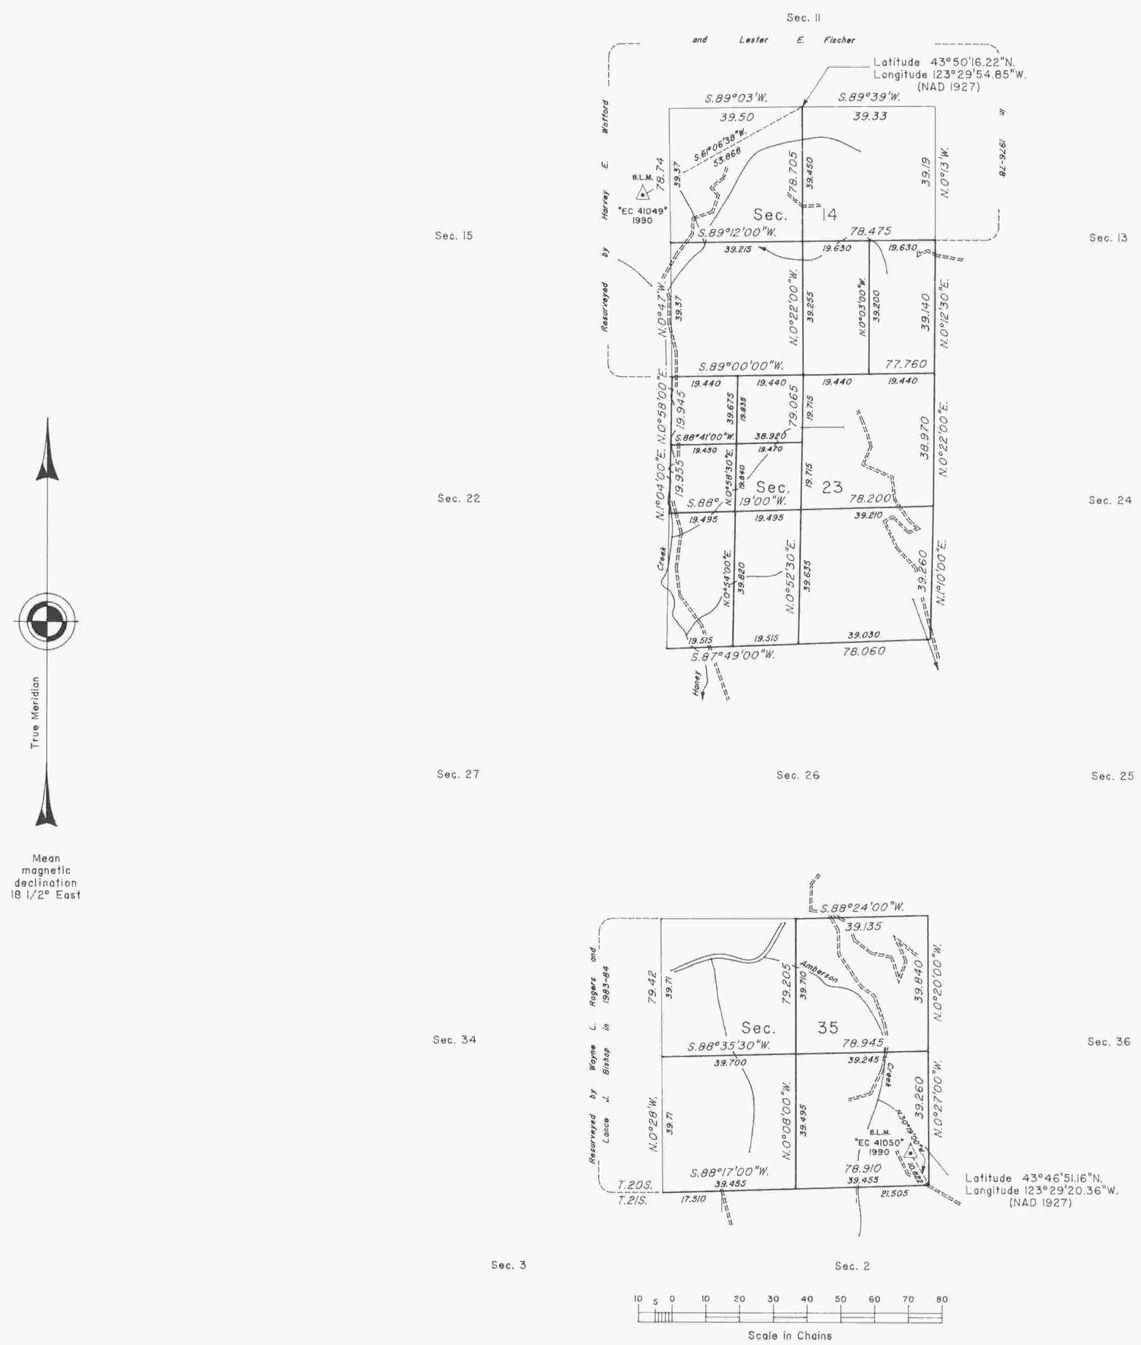

A history of surveys is contained in the field notes.

This plat represents a dependent resurvey of a portion of the south boundary and subdivisional lines, T. 20 S., R. 7 W., Willamette Meridian, Oregon, designed to restore the corners in their true original locations according to the best available evidence, and the subdivision of sections 14, 23, and 35.

The lottings and areas are as shown on the plats approved November 9, 1892.

The survey was executed by Wayne L. Rogers, Cadastral Surveyor, beginning August 28, 1989, and completed April 18, 1991, pursuant to Special Instructions dated July 20, 1989, and Supplemental Special Instructions dated April 24, 1990, under Group Number 1502, Oregon.

Timber in this area consists of fir, cedar, hemlock, yew, alder, cherry, maple, madrone, willow, ash and chinquapin.

UNITED STATES DEPARTMENT OF THE INTERIOR
BUREAU OF LAND MANAGEMENT

Portland, Oregon November 3, 1993

This plat is strictly conformable to the approved field notes, and the survey, having been correctly executed in accordance with the requirements of law and the regulations of this Bureau, is hereby accepted.

For the Director

Wayne M. Gardner

Chief Cadastral Surveyor of Oregon

R.S.B.