5555

ORIGINAL

TOWNSHIP 20 SOUTH, RANGE 9 WEST, OF THE WILLAMETTE MERIDIAN, OREGON.

DEPENDENT RESURVEY

This plat represents a retracement and reestablishment of a portion of the subdivisional lines, T. 20 S., R. 9 W., Willamette Meridian, Oregon, designed to restore the corners in their true original location according to the best available evidence.

A portion of the subdivisional lines was surveyed by William Thiel, in 1877.

A portion of the subdivisional lines was surveyed by William Thiel, 1891.

A portion of the subdivisional lines was resurveyed by Thomas A. Tillman and Joseph S. Gawron, in 1953-54.

Certain original corner points within the township were remonumented without survey by William W. Glenn and James E. Jelley, in 1967.

The resurvey was executed by Owen C. Chatters II, Cadastral Surveyor, from May 30, 1972 to June 27, 1972, under Special Instructions dated March 21, 1972, which provide for the surveys included under Group No. 777, Oregon.

Sec. 30 | Sec. 29 | Sec. 28

MEAN
MAGNETIC
DECLINATION
20°30'E.

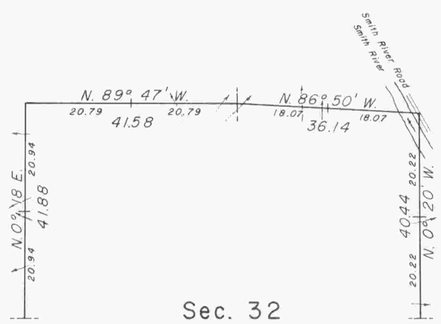

Sec. 31 | Sec. 32 | Sec. 33

Latitude 43° 47.4' N.
Longitude 123° 47.3' W.

UNITED STATES DEPARTMENT OF THE INTERIOR
BUREAU OF LAND MANAGEMENT
Washington, D.C. January 5, 1977

This plat is strictly conformable to the approved field notes, and the survey, having been correctly executed in accordance with the requirements of law and the regulations of this Bureau, is hereby accepted.

For the Director

Acting Chief, Division of Cadastral Survey

Sec. 6 | Sec. 5 | Sec. 4

Timber in this area consists of fir, hemlock, cedar, alder, chinquapin, madrone, yew, and dogwood.

TEB