1396

Township No. 20 South Range 10 West of the Willamette Meridian Oregon

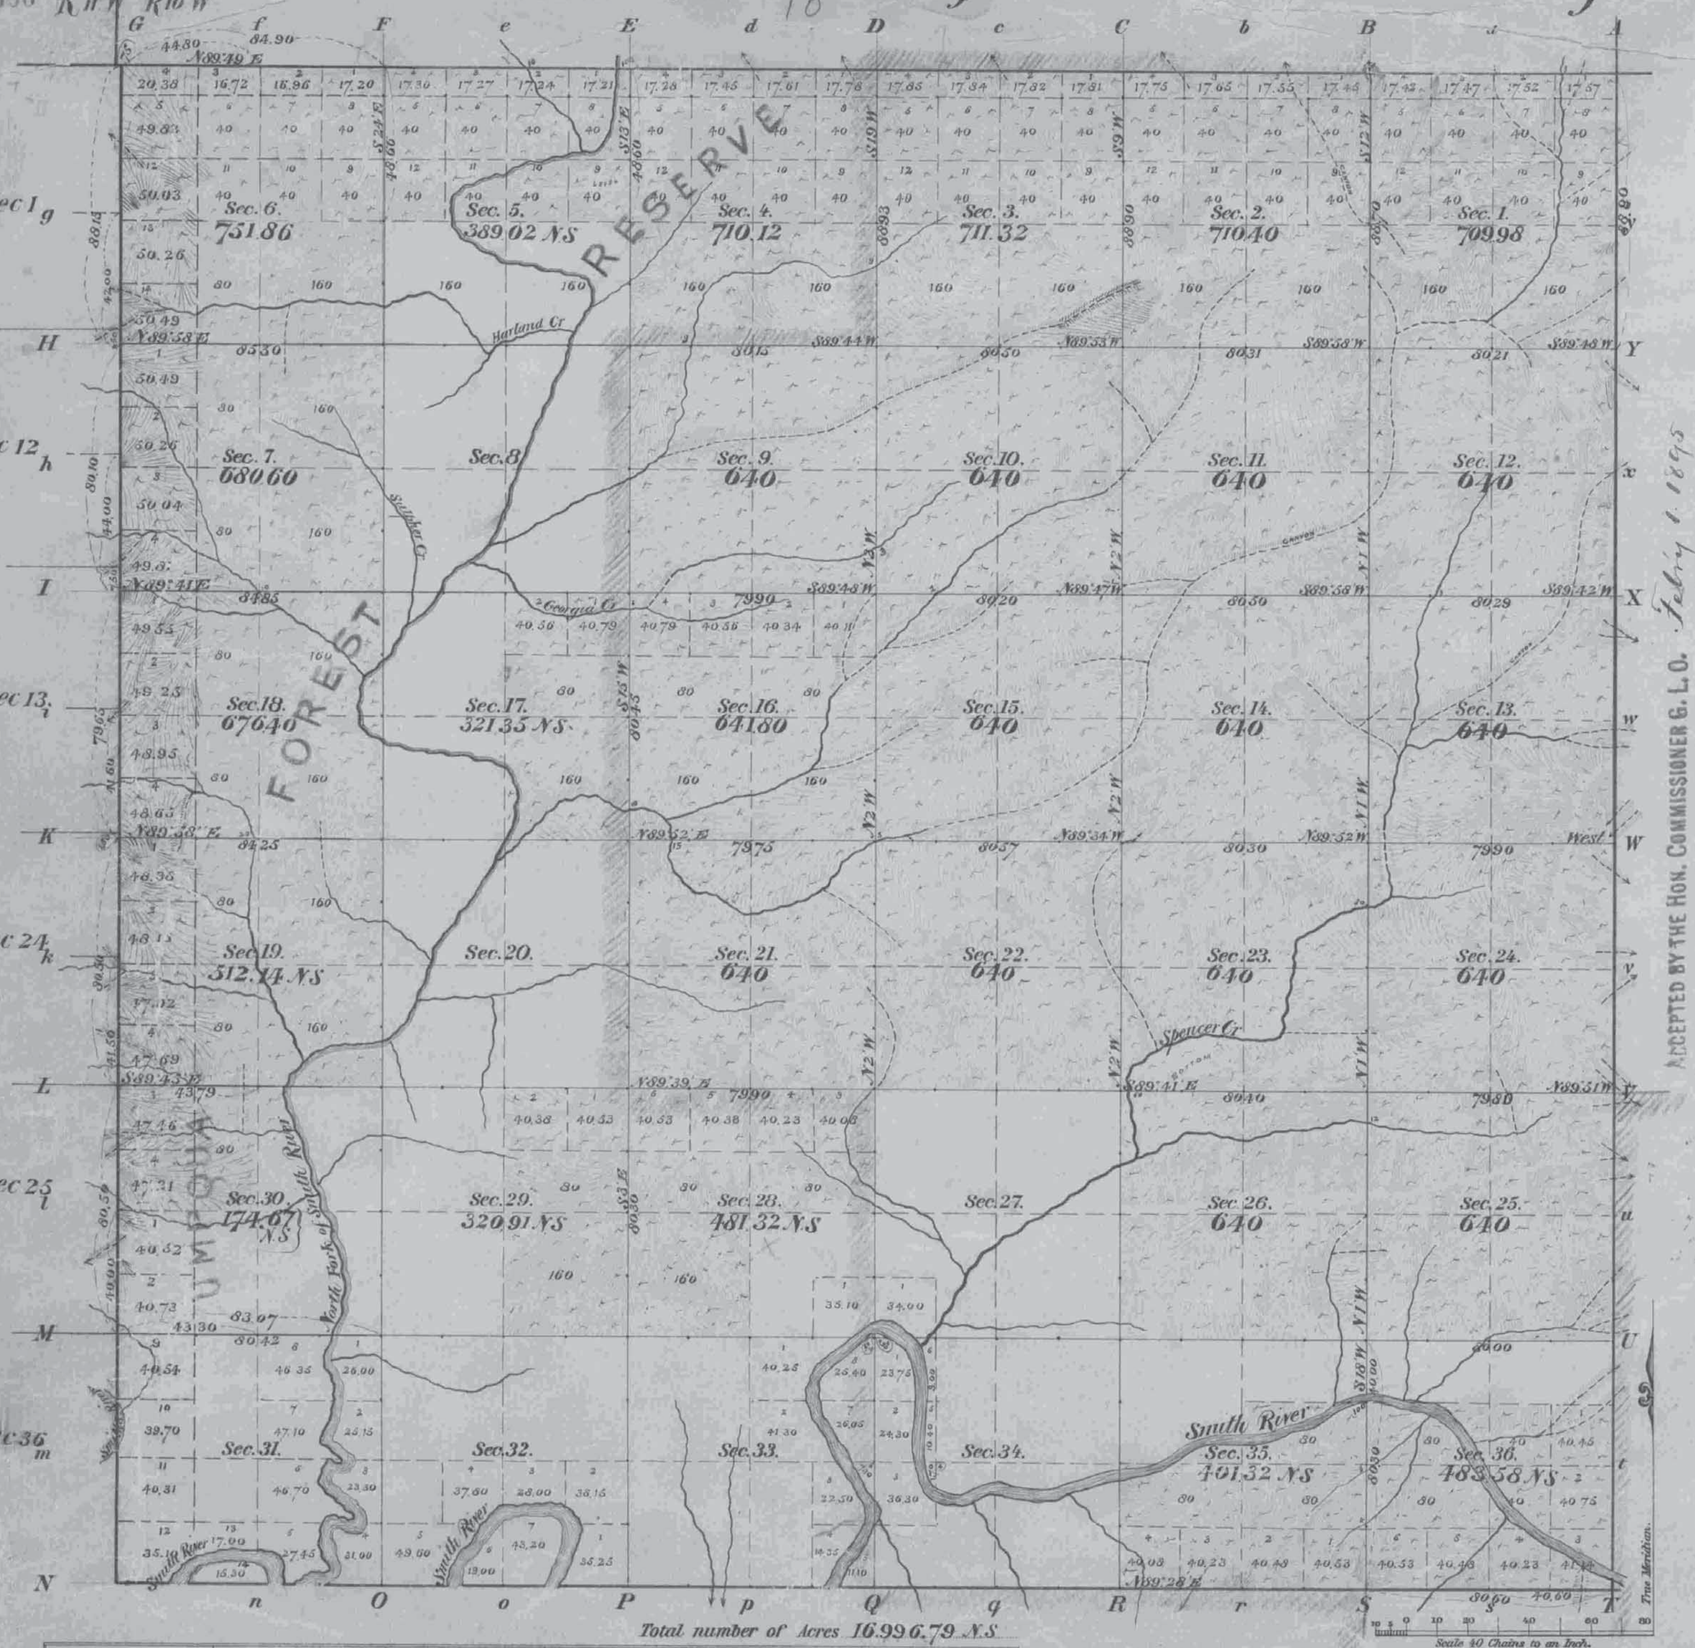

Scale 40 Chains to an Inch.

Total number of Acres 16,996.79 N.S

Surveys Designated	By Whom Surveyed	Date of Contract	Amount of Surveys M.	Ch.s	Lk.s	When Surveyed	Mean Declination
Nand. Bd. of Land S. Township lines	Nathaniel Martin	June 20 1892					
Subdivisions	"	"	36	12	21	September 10th Oct. 10. 1892	19° 15' E
Extension of lines on West Tier of Sections	"	"		13	50		

Contract No. 599

The above Map of Township No. 20 South, of Range No. 10 West of the Willamette Meridian, Oregon is strictly conformable to the field notes of the survey thereof on file in this Office, which have been examined and approved.

Surveyor Generals Office, Portland, Oregon April 13, 1894

W. Henry Byars
Sur. Gen. for Oregon

ACCEPTED BY THE HON. COMMISSIONER G. L. O. Feby 1. 1895

I hereby certify that the above map shows the resurvey of the west boundary of this Township, and the projection of the lines on the west tier of sections to an intersection with the west boundary, and that it is strictly conformable to the field notes of such resurvey now on file in this Office. Surveyed from November 4 to 9. 1894

Surveyor Generals Office, Portland, Oregon January 22 1895

John C. Arnold, Sur. Genl for Oregon

Meanders of								
Posts	Courses	Ch.s Lk.s	Posts	Courses	Ch.s Lk.s	Posts	Courses	Ch.s Lk.s