ORIGINAL

TOWNSHIP 20 SOUTH, RANGE 10 WEST, OF THE WILLAMETTE MERIDIAN, OREGON.

DEPENDENT RESURVEY

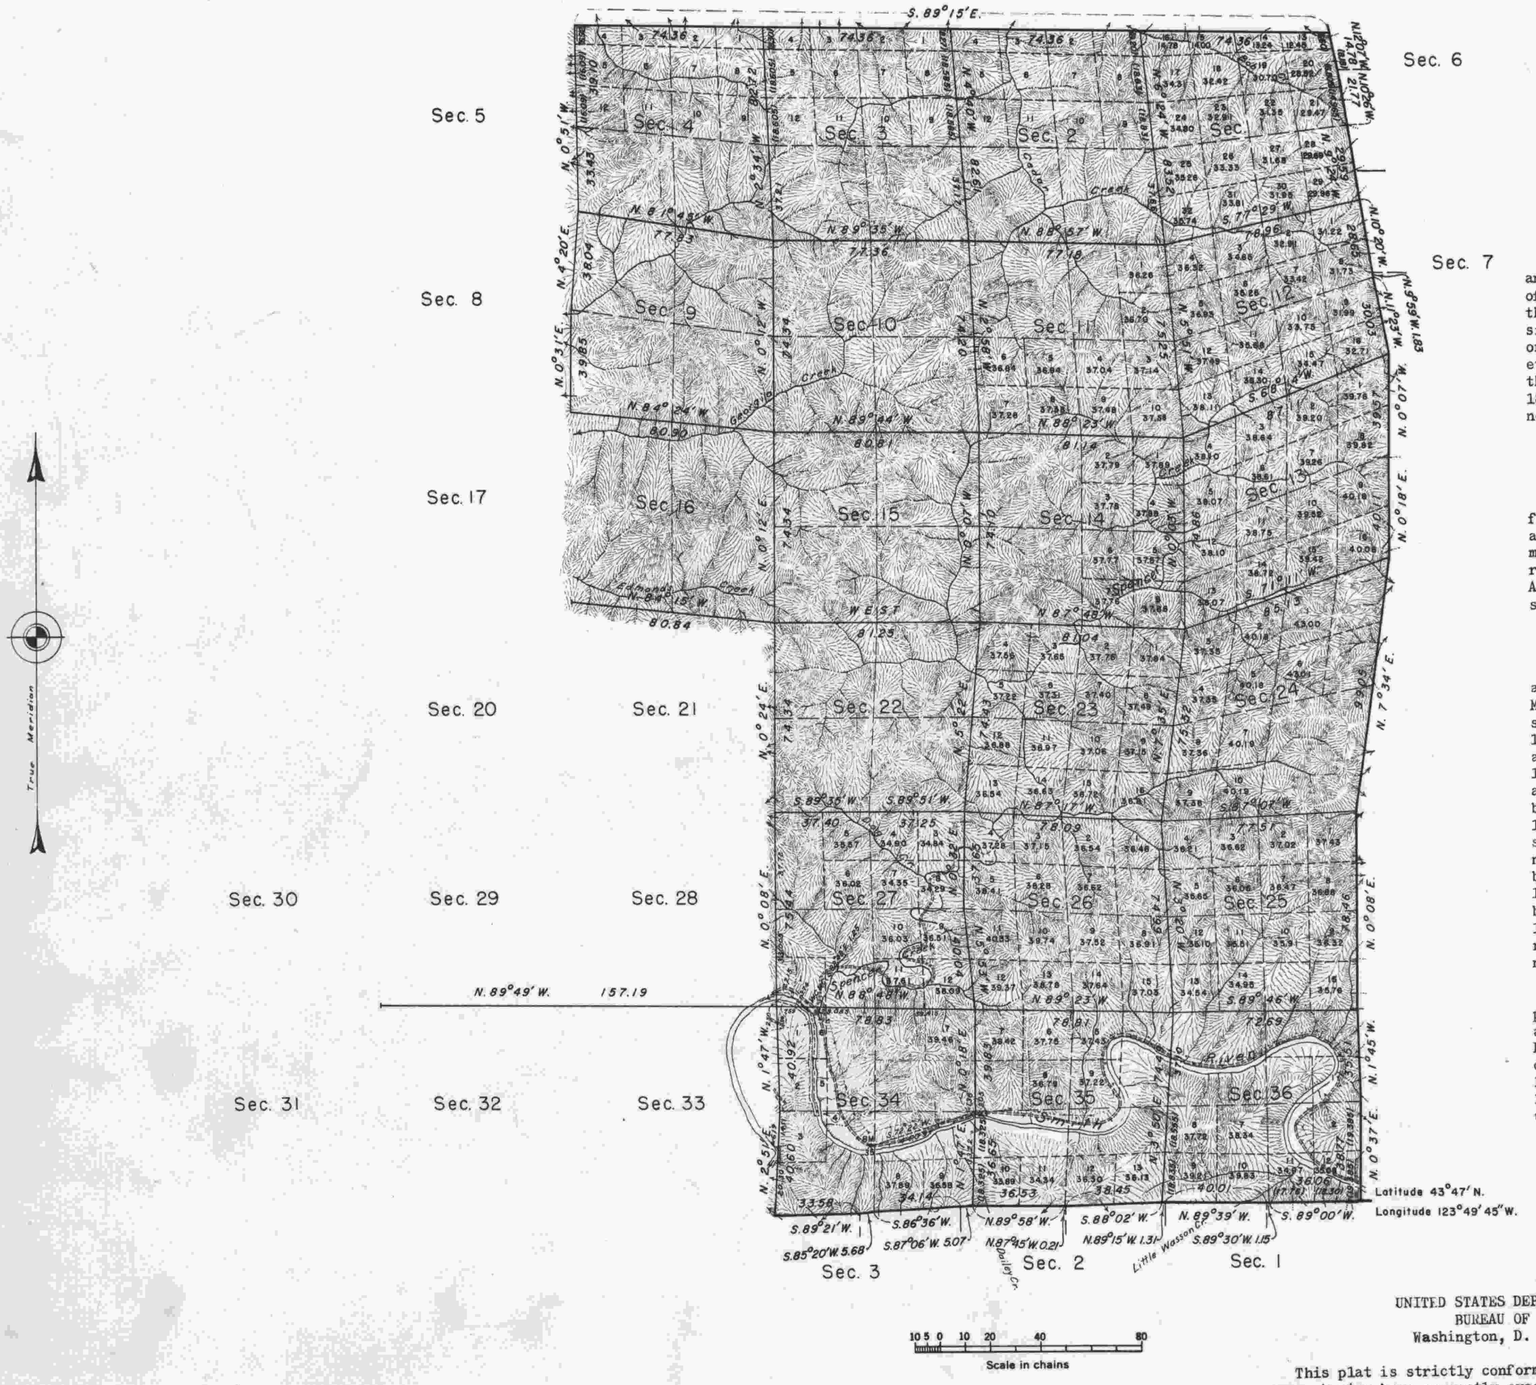

This plat represents a retracement and reestablishment of the east boundary, portions of the north and south boundaries and a portion of the subdivisional lines of T. 20 S., R. 10 W., designed to restore the corners in their true original locations according to the best available evidence. The lottings and areas are as shown on the plats approved September 28, 1867, July 3, 1878, April 19, 1894 and June 12, 1953, except as new lots and areas are shown hereon.

This area heavily timbered with Douglas fir, western hemlock, red cedar, Oregon maple and alder. There is a scattering of chinquapin, madrona, yew, dogwood and cascara throughout the region with some willow and ash along the river. A small clump of myrtle is located along the south boundary of sec. 36.

HISTORY OF SURVEYS

Portions of south and west boundaries and subdivisional lines surveyed by John W. Meldrum in 1867. Portions of east boundary and subdivisional lines surveyed by W. H. Byars in 1874. A portion of east boundary resurveyed and portions of east boundary and subdivisional lines surveyed in 1877 and 1878 by William Thiel and F. M. Johnson. Portions of east and west boundaries surveyed by William Thiel in 1891 and 1892. Portions of south and west boundaries and subdivisional lines resurveyed in 1892-1894 and north boundary and portions of south and east boundaries and subdivisional lines surveyed in 1892 by Nathaniel Martin. A portion of south boundary resurveyed by Charles M. Collier in 1918. Portions of south and east boundaries resurveyed in 1919 and 1922 and portion of north boundary retraced in 1922 by Fred Mensch.

Dependent resurvey of the east boundary, portions of the north and south boundaries, and a portion of the subdivisional lines of T. 20 S., R. 10 W., executed by Thomas A. Tillman, Cadastral Engineer, May 28, 1951 to October 17, 1952, under Special Instructions dated March 14, 1951, which provide for the surveys included under Group No. 297 Oregon.

Area Resurveyed: 12,859.74 Acres

UNITED STATES DEPARTMENT OF THE INTERIOR
BUREAU OF LAND MANAGEMENT
Washington, D. C., March 18, 1954

This plat is strictly conformable to the approved field notes, and the survey, having been correctly executed in accordance with the requirements of law and the regulations of this Bureau, is hereby accepted.

For the Director

Donald B Clement

Assistant Chief, Division of
Cadastral Engineering

REM

LRH

58584