Township No. 20 South Range No. 11 West of the Willamette Meridian Oregon

1499

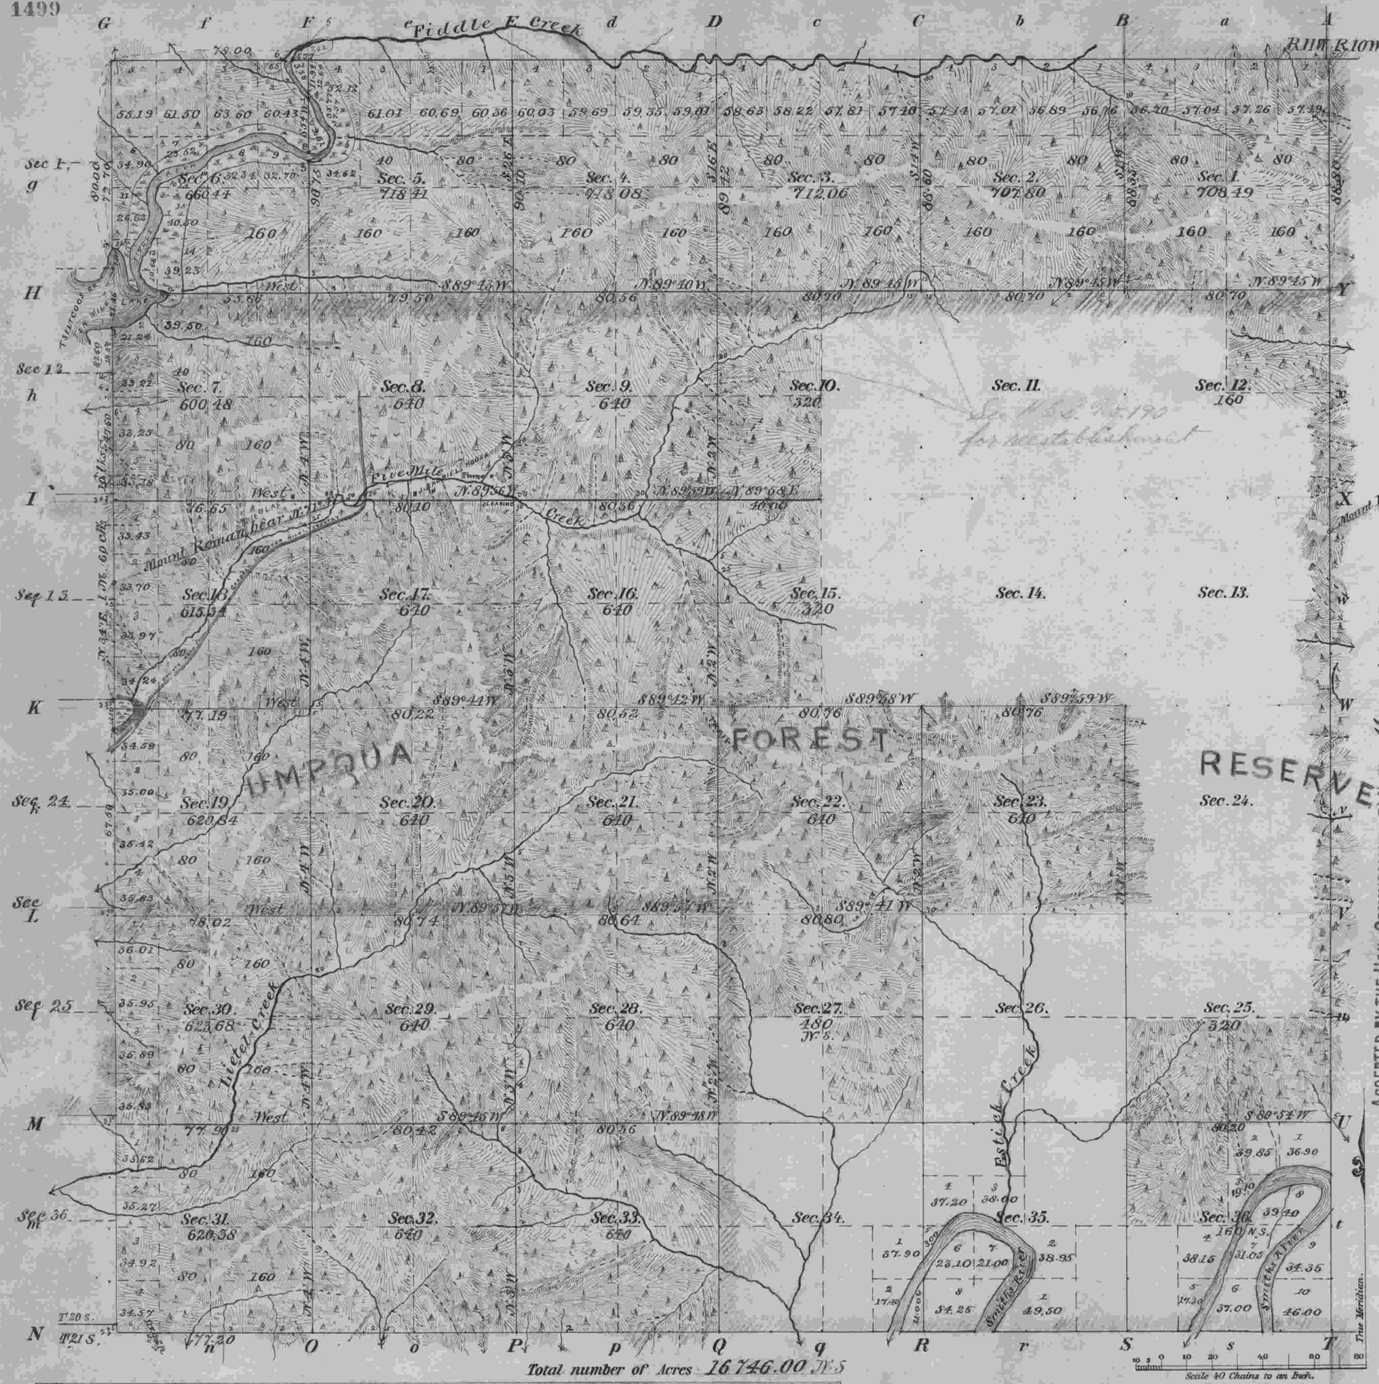

Meanders of

Posts	Courses	Ch.s Lk.s	Posts	Courses	Ch.s Lk.s	Posts	Courses	Ch.s Lk.s

ACCEPTED BY THE HON. COMMISSIONER G. L. O. May 22 1893

Total number of Acres 16 746.00 N.S.

Surveys Designated	By Whom Surveyed	Date of Contract	Amount of Surveys M. Ch. Lks	When Surveyed	Mean Declination
Township lines	William Thiel	February 16 1891		May 10 to June 21 1892	20° 00' E
Subdivisions	" "	" "	43. 60. 88		
Meanders	" "	" "	4. 53 88		
Connections	" "	" "	13. 10		
Contract No 567					

The above Map of Township No. 20 South, of Range No. 11 West Willamette Meridian Oregon is strictly conformable to the field notes of the survey thereof on file in this Office, which have been examined and approved.

Surveyor Generals Office
Portland Oregon May 6 1893

W. Henry Byars
Sur. Gen.l