T20S R12W
N½ bet.
8/9
Should be 41.66

TOWNSHIP 20 SOUTH, RANGE 12 WEST, OF THE WILLAMETTE MERIDIAN, OREGON.

DEPENDENT RESURVEY, RETRACEMENT, SUBDIVISION OF SECTIONS 3,4,8,17,20,29, AND 32, AND SURVEY

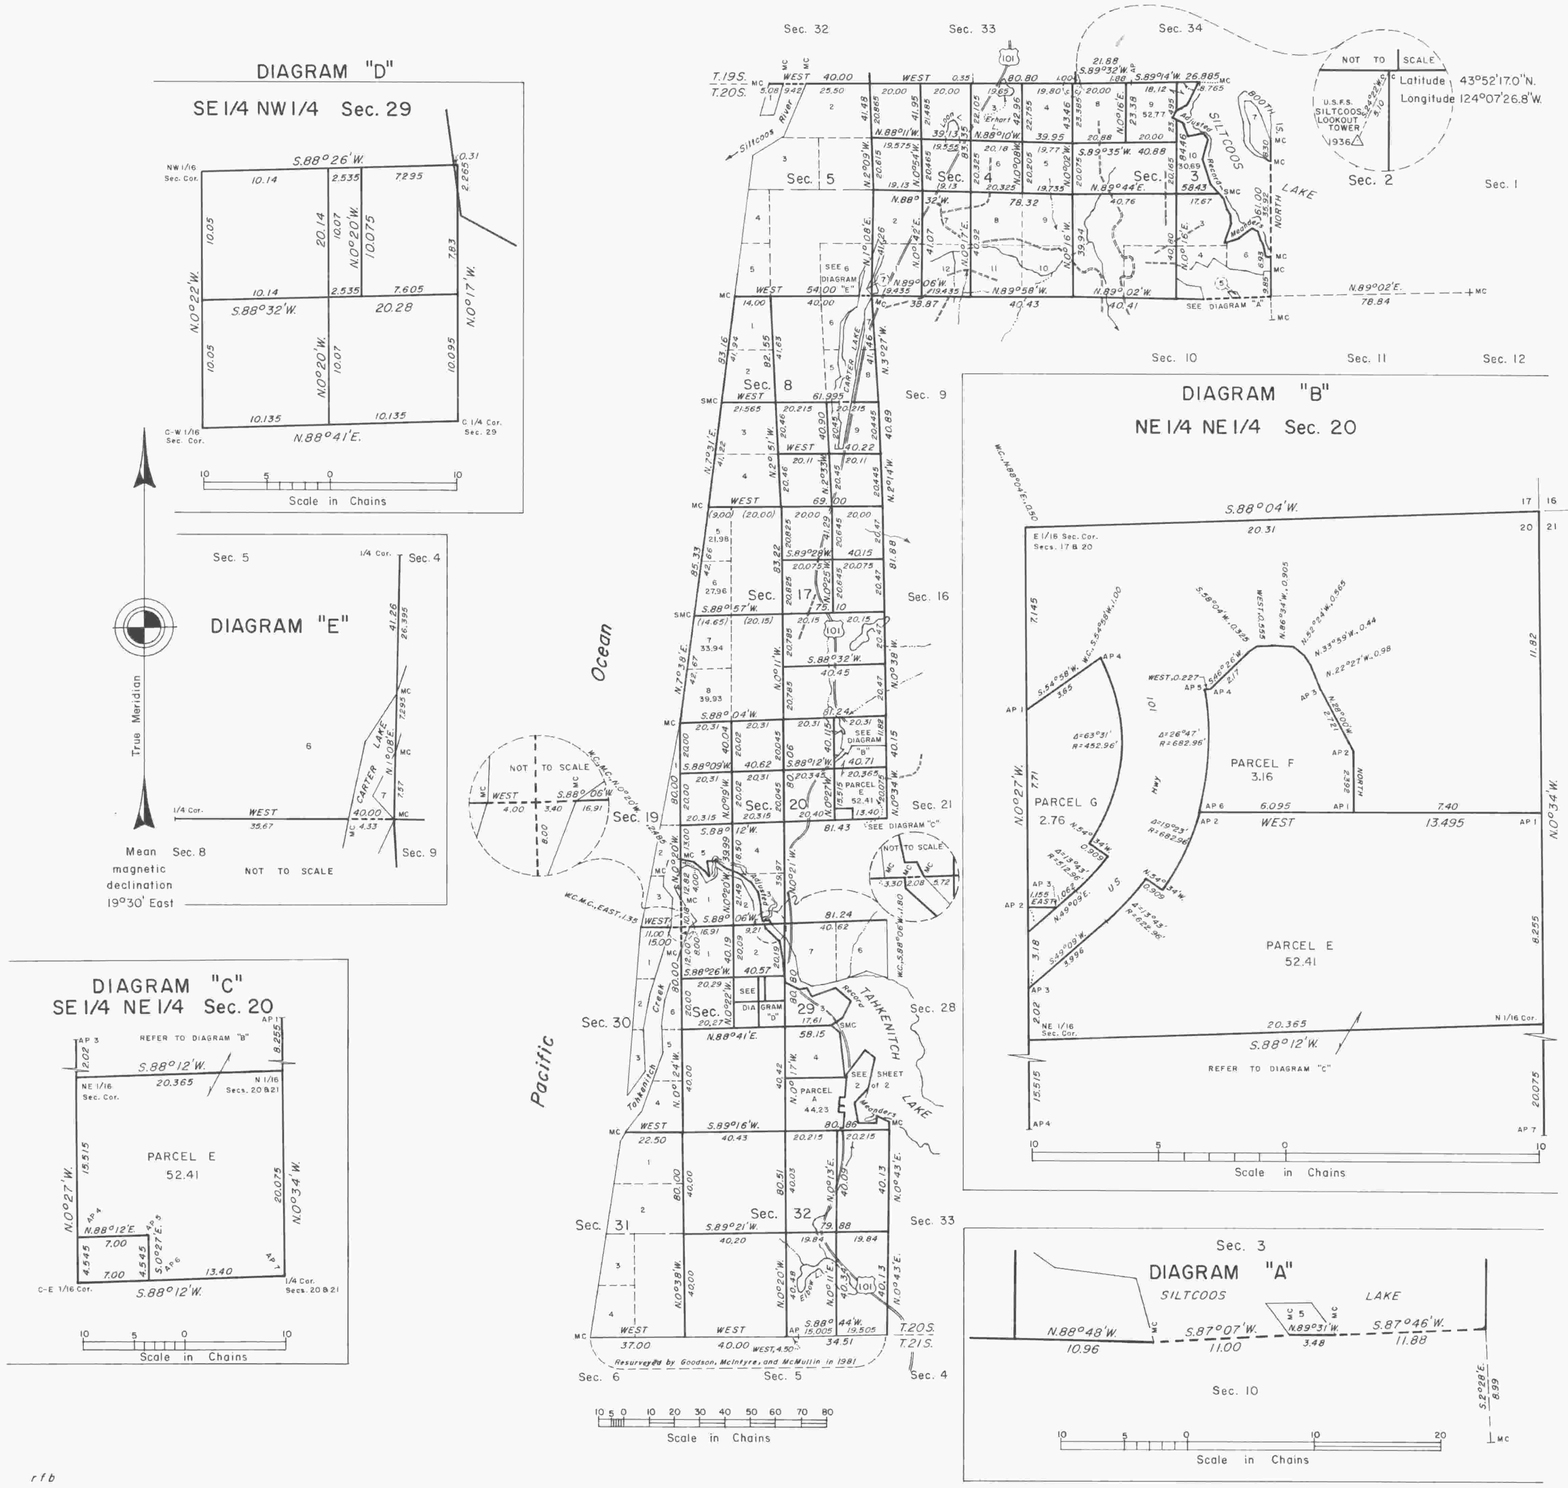

A history of surveys is contained in the field notes.

This plat represents a dependent resurvey of a portion of the north boundary and subdivisional lines, the retracement of the meanders of the Pacific Ocean, Siltcoos Lake, Tahkenitch Lake, and Takenitch Creek, T. 20 S., R. 12 W., Willamette Meridian, Oregon, designed to restore the corners in their true original locations according to the best available evidence, the subdivision of sections 3, 4, 8, 17, 20, 29, and 32, and the metes-and-bounds survey of certain parcels.

The lottings and areas are as shown on the plats approved September 6, 1858 and June 26, 1907.

The survey was executed by Glenn F. Goodson, Rick E. Tawney, and Elma J. Acuna, Cadastral Surveyors, beginning September 11, 1981 and completed October 5, 1982, pursuant to Special Instructions dated October 7, 1981, for Group No. 1077, Oregon.

Timber in this area consists of shore pine, spruce, fir, cedar, hemlock, alder, chinquapin, and cascara.

UNITED STATES DEPARTMENT OF THE INTERIOR
BUREAU OF LAND MANAGEMENT
Portland, Oregon January 27, 1984

This plat is strictly conformable to the approved field notes, and the survey, having been correctly executed in accordance with the requirements of law and the regulations of this Bureau, is hereby accepted.

For the Director

William W. Glenn

Chief Cadastral Surveyor of Oregon

rfb