ORIGINAL

TOWNSHIP 21 SOUTH, RANGE 4 WEST, OF THE WILLAMETTE MERIDIAN, OREGON

CORRECTIVE DEPENDENT RESURVEY, DEPENDENT RESURVEY, AND SUBDIVISION OF SECTION 27

FILED
Date: 1/12/2009 By: JC
This survey consists of:
~~Map~~: BLM LINE NOTES
~~Narrative~~: VOL. 55
~~Corner Rpt~~: PAGES 21522-36
DOUGLAS COUNTY SURVEYOR

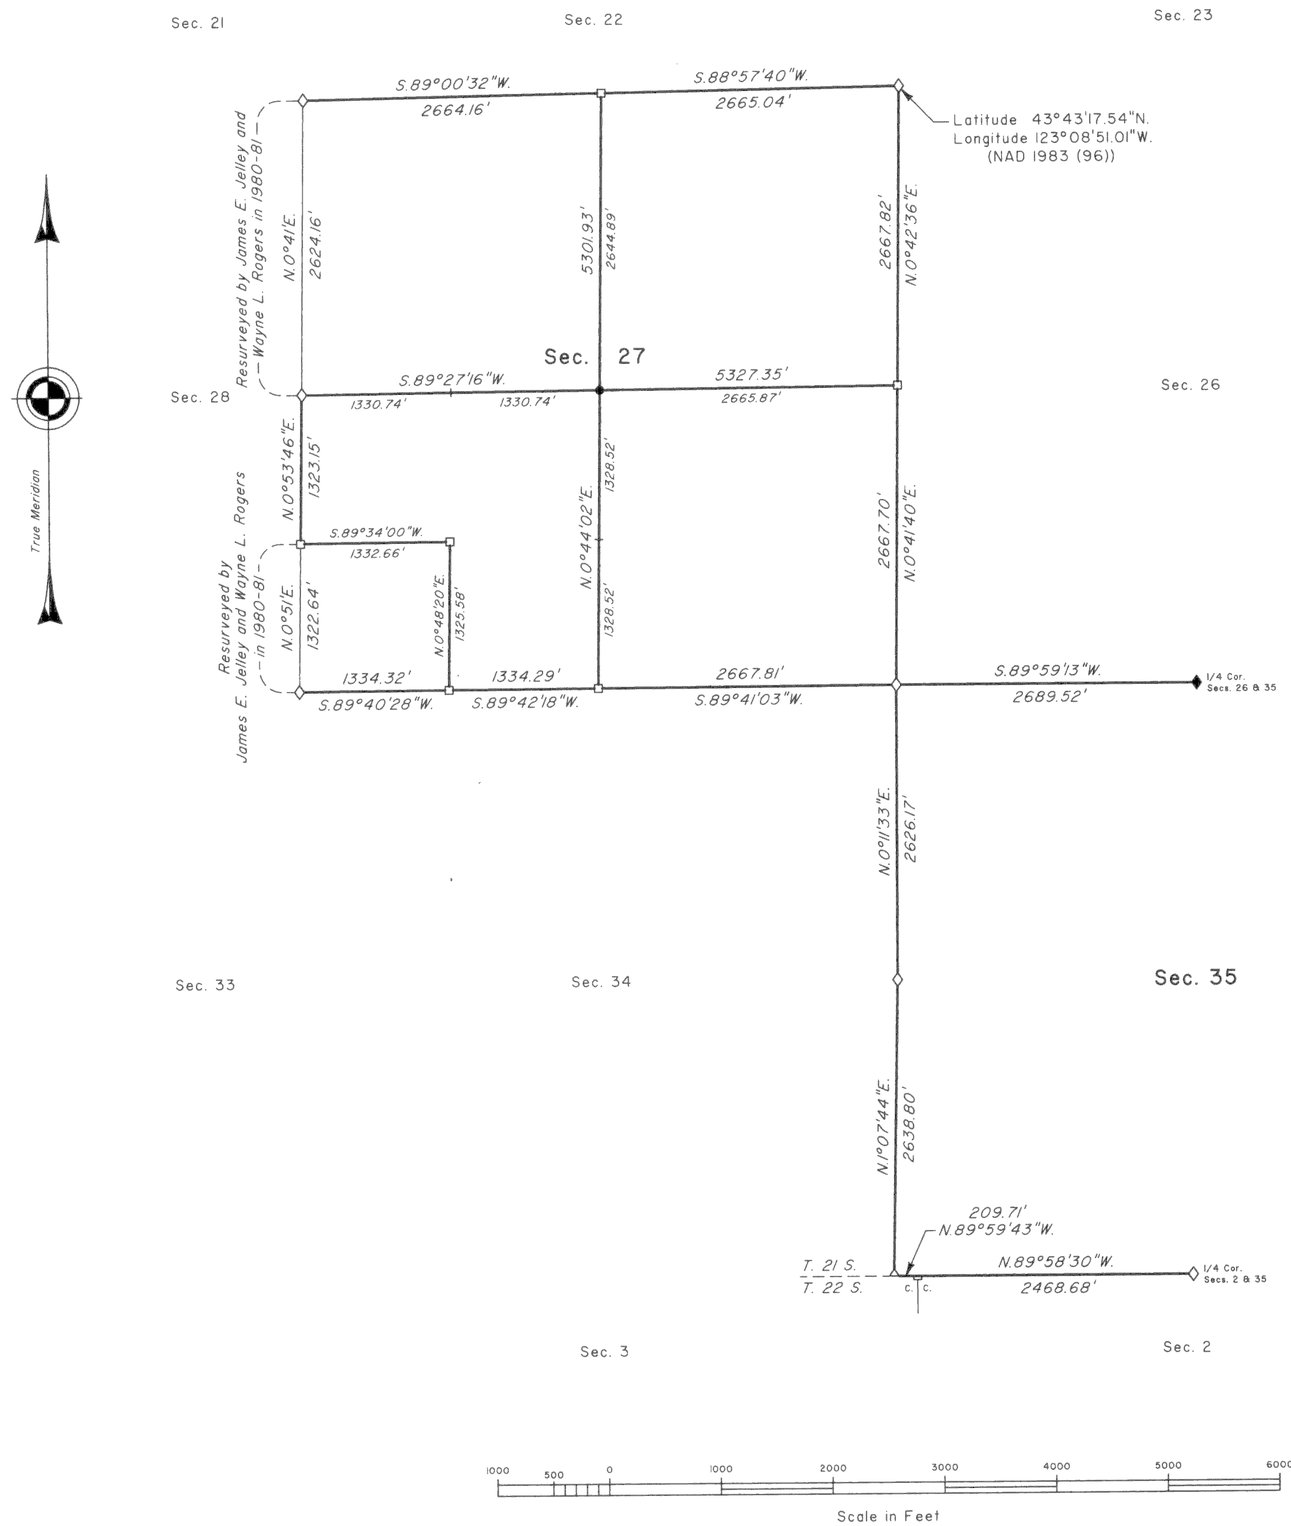

LEGAL SUBDIVISION	OFFICIAL ACRES
SECTION 27	
NE1/4 NE1/4	40.70
NW1/4 NE1/4	40.53
SW1/4 NE1/4	40.54
SE1/4 NE1/4	40.71
NE1/4 NW1/4	40.34
NW1/4 NW1/4	40.18
SW1/4 NW1/4	40.16
SE1/4 NW1/4	40.32
NE1/4 SW1/4	40.56
NW1/4 SW1/4	40.48
SE1/4 SW1/4	40.62
NE1/4 SE1/4	40.77
NW1/4 SE1/4	40.69
SW1/4 SE1/4	40.71
SE1/4 SE1/4	40.79

A history of surveys is contained in the field notes.

This plat represents a corrective dependent resurvey of a portion of the subdivisional lines, and a dependent resurvey of a portion of the south boundary, and a portion of the subdivisional lines, T. 21 S., R. 4 W., Willamette Meridian, Oregon, designed to restore the corners in their true original locations according to the best available evidence, and the subdivision of section 27.

Measured distances and directions have been adjusted by computer software that incorporates a least squares adjustment routine. The adjusted bearings and distances are reported to the nearest second and 0.01 foot.

Actual quantity acreages have been returned for federal interest lands where indicated. Aliquot parts and lots retain their existing designation even though the official acreage has changed. Aliquot parts of a section will continue to be determined by legal subdivision in accordance with the Manual. When an area has been assigned a lot number, it may be further subdivided only by a supplemental plat or another official survey. Official lottings and areas of federal interest lands not affected by this survey are as shown on the plat approved February 20, 1856.

The survey was executed by Harvey M. Christensen, Oregon Registered Land Surveyor No. 2603, beginning November 1, 2007, and completed August 9, 2008, pursuant to Special Instructions dated July 17, 2007, and Supplemental Special Instructions dated August 8, 2008, under Group Number 2171, Oregon.

LEGEND

- ◇ Original corner previously remonumented
- ◆ Original corner remonumented this survey
- □ Corner previously established or reestablished
- ● Corner established or reestablished this survey

UNITED STATES DEPARTMENT OF THE INTERIOR
BUREAU OF LAND MANAGEMENT

Portland, Oregon

This plat is strictly conformable to the approved field notes, and the survey, having been correctly executed in accordance with the requirements of law and the regulations of this Bureau, is hereby accepted.

For the Director

John P. Fairsworth, Acting

Chief Cadastral Surveyor of Oregon

November 24, 2008

Date