TOWNSHIP 21 SOUTH, RANGE 5 WEST, OF THE WILLAMETTE MERIDIAN, OREGON

DEPENDENT RESURVEY AND SUBDIVISION OF SECTIONS 3 AND 19

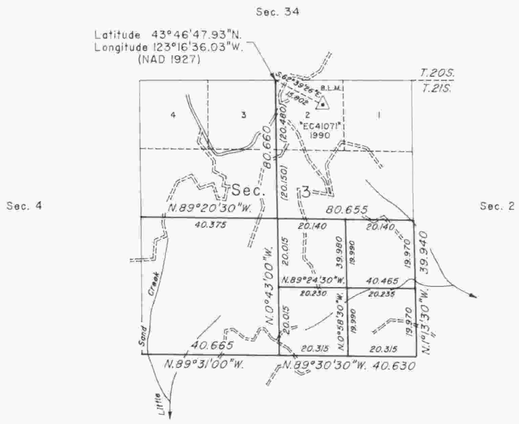

A history of surveys is contained in the field notes.

This plat represents a dependent resurvey of a portion of the subdivisional lines, T. 21 S., R. 5 W., Willamette Meridian, Oregon, designed to restore the corners in their true original locations according to the best available evidence, and the subdivision of sections 3 and 19.

The lottings and areas are as shown on the plat approved February 25, 1885.

The survey was executed by Bryan S. Seibold, Cadastral Surveyor, beginning August 22, 1990, and completed November 27, 1990, pursuant to Special Instructions dated August 2, 1990, under Group Number 1564, Oregon.

Timber in this area consists of fir, cedar, hemlock, yew, chinquapin, pine, ash, alder, oak, maple, dogwood, hazel and madrone.

Mean magnetic declination 19 3/4° East

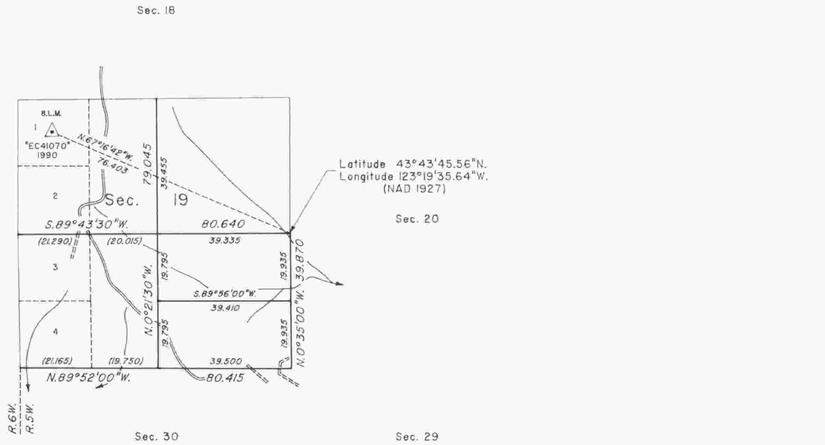

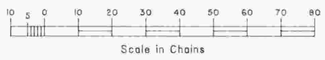

UNITED STATES DEPARTMENT OF THE INTERIOR
BUREAU OF LAND MANAGEMENT

Portland, Oregon November 22, 1993

This plat is strictly conformable to the approved field notes, and the survey, having been correctly executed in accordance with the requirements of law and the regulations of this Bureau, is hereby accepted.

For the Director

Wayne M. Gardner

Chief Cadastral Surveyor of Oregon

R.S.B.