ORIGINAL

TOWNSHIP 21 SOUTH, RANGE 7 WEST, OF THE WILLAMETTE MERIDIAN, OREGON.

DEPENDENT RESURVEY

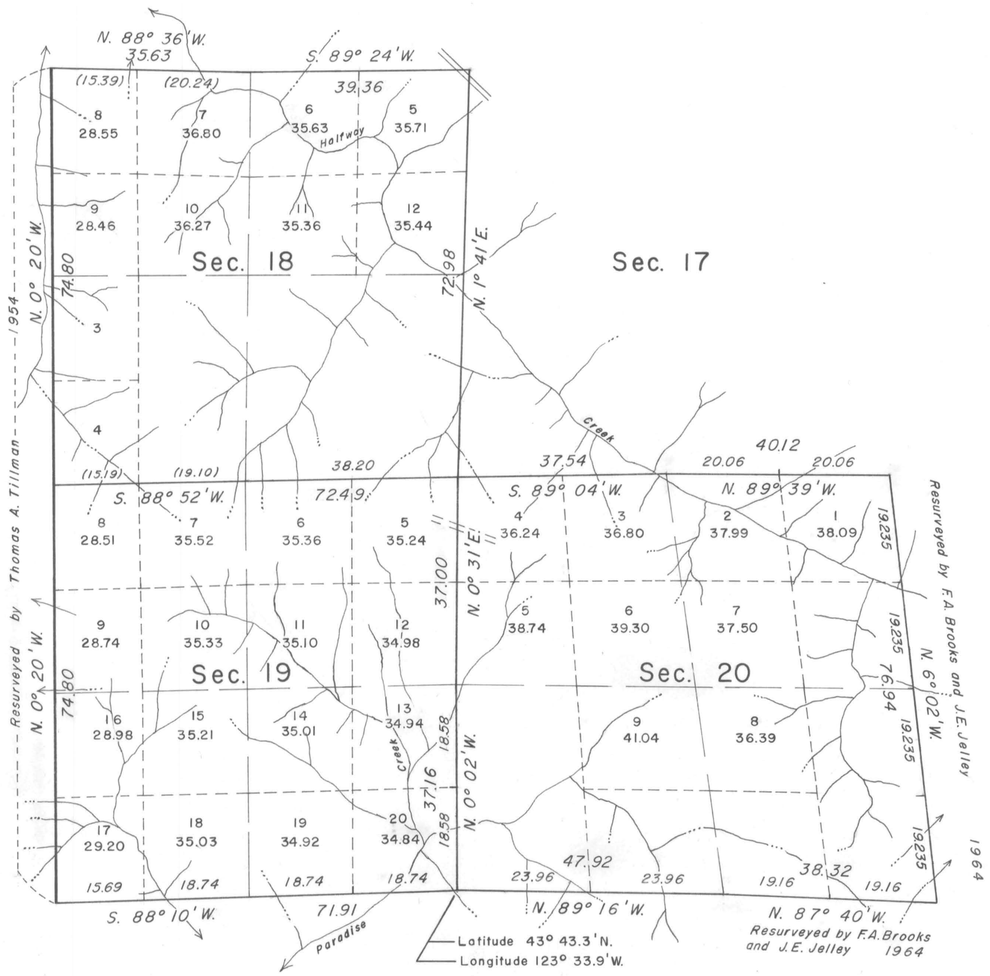

Mean Magnetic Declination 20°00' East

This plat represents a retracement and reestablishment of a portion of the subdivisional lines, T. 21 S., R. 7 W., Willamette Meridian, Oregon, designed to restore the corners in their true original locations according to the best available evidence.

Except as new or modified vacant subdivisions are shown hereon, the lottings and areas are as shown on the plat approved February 25, 1885.

The subdivisional lines were surveyed by William P. Wright in 1884.

Thomas A. Tillman dependently resurveyed the north four miles of the west boundary in 1954.

Floyd A. Brooks and James E. Jelley dependently resurveyed a portion of the subdivisional lines in 1964.

The resurvey was executed by Donald R. Beck, Cadastral Surveyor, beginning September 8, 1967, and completed October 11, 1967, under Special Instructions dated August 31, 1967, which provide for the surveys included under Group No. 655, Oregon.

UNITED STATES DEPARTMENT OF THE INTERIOR
BUREAU OF LAND MANAGEMENT
Washington, D. C. February 20, 1970

This plat is strictly conformable to the approved field notes, and the survey, having been correctly executed in accordance with the requirements of law and the regulations of this Bureau, is hereby accepted.

For the Director

Chief, Division of Cadastral Survey

Timber in this area consists of fir, hemlock, cedar, maple, alder, dogwood, chinquapin, madrone, and yew.

"Suspended December 5, 2005, see File 9632 (OR957)"

10 5 0 10 20 30 40
Chains

Area resurveyed: 1,734.12 Acres

BmK 8-69