TOWNSHIP 21 SOUTH, RANGE 8 WEST, OF THE WILLAMETTE MERIDIAN, OREGON

CORRECTIVE DEPENDENT RESURVEY

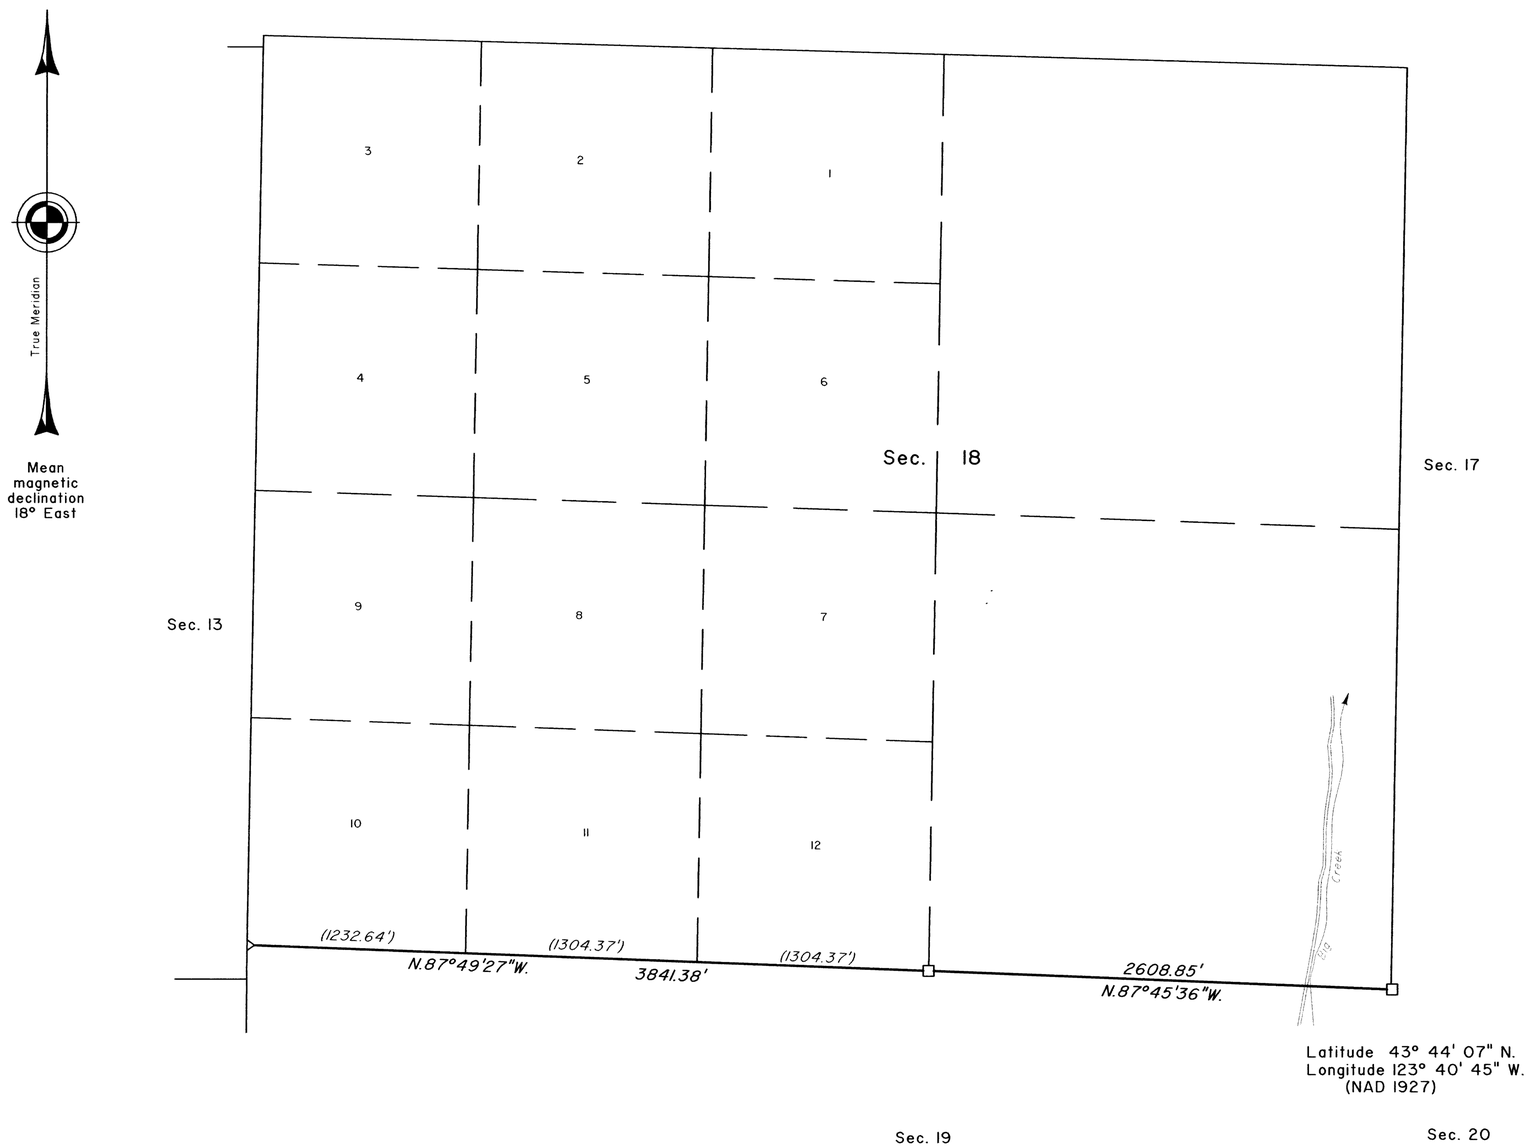

A history of surveys is contained in the field notes.

This plat represents a corrective dependent resurvey of a portion of the subdivisional lines, T. 21 S., R. 8 W., Willamette Meridian, Oregon, designed to restore the corners in their true original locations according to the best available evidence.

Measured distances and directions have been adjusted by Cadastral Measurement Management for Windows (WinCMM), computer software that incorporates a least squares adjustment routine. The adjusted bearings and distances are reported to the nearest second and 0.01 foot.

The lottings and areas are as shown on the plat approved August 4, 1884.

The survey was executed by Aaron M. Graham, Cadastral Surveyor, beginning December 2, 2002, and completed February 13, 2003, pursuant to Special Instructions dated March 12, 2002, Assignment Instructions dated March 20, 2002, under Group Number 2011, Oregon.

Timber in this area consists of fir, cedar, hemlock, maple and alder.

LEGEND

◇ Original corner previously remonumented

□ Corner previously established or reestablished

UNITED STATES DEPARTMENT OF THE INTERIOR
BUREAU OF LAND MANAGEMENT

Portland, Oregon December 4, 2003

This plat is strictly conformable to the approved field notes, and the survey, having been correctly executed in accordance with the requirements of law and the regulations of this Bureau, is hereby accepted.

For the Director

Mary J. M. Hartel

Chief Cadastral Surveyor of Oregon

600 300 0 600 1200 1800 2400 3000 3600 4200 4800

Scale in Feet

SLP