ORIGINAL

FILED
Date: 6/9/2010 By: JC
This survey consists of:
~~Map~~:
~~Narrative~~: VOL 56
~~Corner Rpt~~: PGS 22044-22073

DOUGLAS COUNTY SURVEYOR

OFFICIALLY FILED: 4/23/2010

TOWNSHIP 21 SOUTH, RANGE 8 WEST, OF THE WILLAMETTE MERIDIAN, OREGON

DEPENDENT RESURVEY AND SUBDIVISION OF SECTIONS 24 AND 26

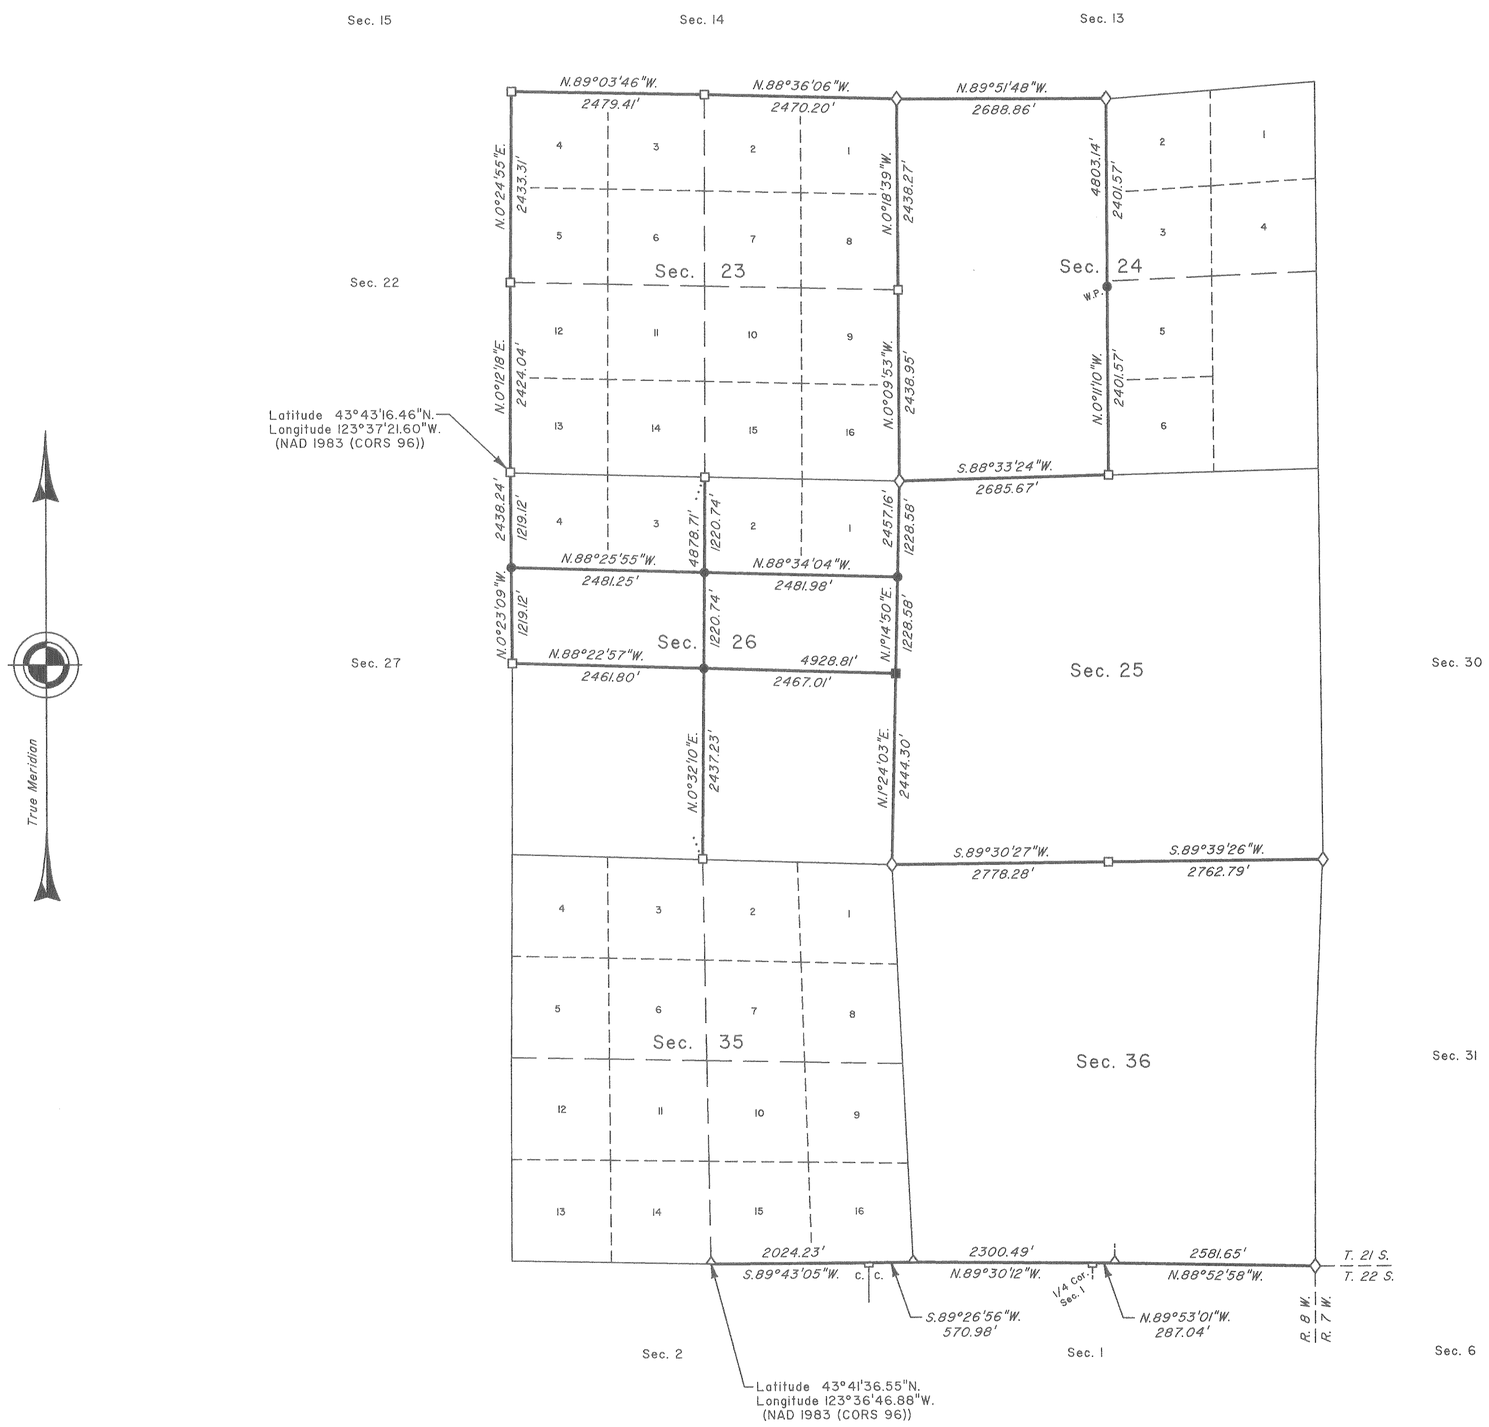

A history of surveys is contained in the field notes.

This plat represents the dependent resurvey of a portion of the South boundary and subdivisional lines, T. 21 S., R. 8 W., Willamette Meridian, Oregon, designed to restore the corners in their true original locations according to the best available evidence, and the subdivision of sections 24 and 26.

Measured distances and directions have been adjusted by computer software that incorporates a least squares adjustment routine. The adjusted bearings and distances are reported to the nearest second and 0.01 foot.

The lottings and areas are as shown on the plats approved August 4, 1884, and April 14, 1960.

The survey was executed by Edith M. Farkner, Cadastral Surveyor, beginning January 24, 2007, and completed May 1, 2007, pursuant to Special Instructions dated July 11, 2005, under Group Number 2115, Oregon.

LEGEND

- ◇ Original corner previously remonumented
- □ Corner previously established or reestablished
- ■ Corner previously reestablished; remonumented this survey
- ● Corner established this survey

UNITED STATES DEPARTMENT OF THE INTERIOR
BUREAU OF LAND MANAGEMENT

Portland, Oregon

This plat is strictly conformable to the approved field notes, and the survey, having been correctly executed in accordance with the requirements of law and the regulations of this Bureau, is hereby accepted.

For the Director

Mary J. M. Hunt

Chief Cadastral Surveyor of Oregon

April 5, 2010

Date

A38