TOWNSHIP 21 SOUTH, RANGE 9 WEST, OF THE WILLAMETTE MERIDIAN, OREGON

DEPENDENT RESURVEY AND SUBDIVISION OF SECTION

FILED
Date: 8/8/2011 By: JC
This survey consists of:
Map: VOL. 56 PAGES
~~Narrative:~~ 22325-22349
~~Corner Rpt:~~
DOUGLAS COUNTY SURVEYOR

OFFICIALLY FILED: 6/8/11

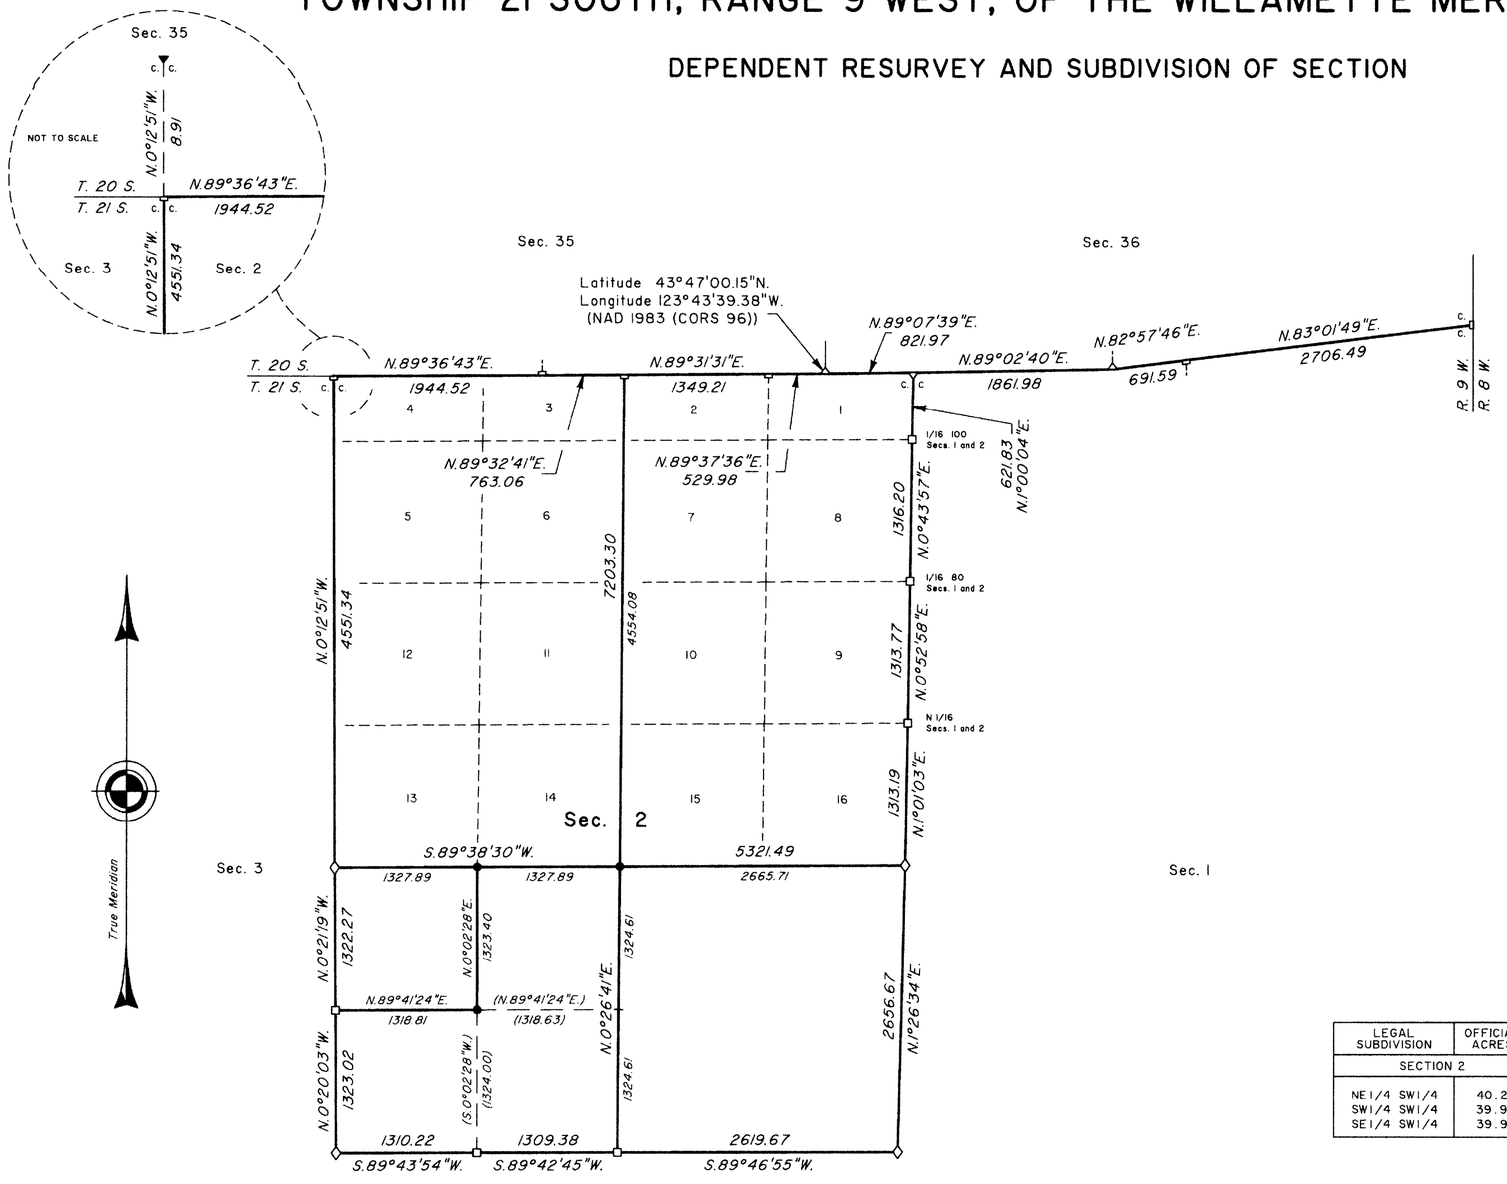

A history of surveys, corner descriptions, and other relevant information is contained in the field notes.

This plat represents the dependent resurvey of a portion of the south boundary, T. 20 S., R. 9 W., and a portion of the subdivisional lines, T. 21 S., R. 9 W., designed to restore the corners in their true original locations according to the best available evidence, and the subdivision of sec. 2., T. 21 S., R. 9 W., Willamette Meridian, Oregon.

Official area based on the measurements of this survey have been returned for Federal Interest lands where indicated. Aliquot part legal subdivisions retain their aliquot characteristics and refer to precisely the same land as that which was previously identified by its original survey or description. A lot can only be subdivided by survey or a supplemental plat. Except as indicated hereon, the lottings and areas are as shown on the plat approved September 21, 1896.

Survey executed by Edith M. Forkner, Cadastral Surveyor, beginning October 27, 2009, and completed June 29, 2010, pursuant to special instructions dated October 15, 2009, for Group Number 2286, Oregon.

LEGAL SUBDIVISION	OFFICIAL ACRES
SECTION 2	
NE1/4 SW1/4	40.22
SW1/4 SW1/4	39.94
SE1/4 SW1/4	39.95

LEGEND

- ◇ Original corner previously remonumented
- ◆ Original corner remonumented this survey
- □ Corner previously established or reestablished
- ● Corner established this survey
- \+ Corner point calculated, no monument set
- ( ) Calculated bearing and distance

1000 500 0 1000 2000 3000 4000 5000 6000
Scale in Feet

UNITED STATES DEPARTMENT OF THE INTERIOR
BUREAU OF LAND MANAGEMENT

Portland, Oregon

This plat is strictly conformable to the approved field notes, and the survey, having been correctly executed in accordance with the requirements of law and the regulations of this Bureau, is hereby accepted.

For the Director

John A. Farnsworth, Acting

Chief Cadastral Surveyor of Oregon

April 20, 2011
Date

B.C.W.