Township No. 21 South, Range No. 10 West, Willamette Meridian, Oregon.

(continued from column to the right)

S.70°00'W. 1.40 Chs.
West 11.00 "
N.85°00'W. 2.50 "
N.75°00'W. 4.50 "
N.85°00'W. 8.00 "
N.70°00'W. 5.00 "
N.80°00'W. 3.00 "
N.72°00'W. 5.00 "
N.55°00'W. 9.50 "
N.25°00'W. 5.00 "
N.10°00'W. 1.00 "
N. 5°00'E. 3.00 "
N.13°00'E. 4.50 "
N.29°45'E. 6.00 "
N.20° E. 7.50 "
N.35° E. 6.00 "
N.25°00'E. 5.00 " N. Fork. Up N. Fork.
N.68°00'E. 1.00 "
N.45°00'E. 2.00 "
N.59°00'E. 3.40 "
N.70°00'E. 1.00 "
N.86°00'E. 3.00 "
N.65°00'E. 2.00 "
N.40°00'E. 2.00 "
N.60°00'E. 2.00 "
N. 8°00'E. 1.50 "
N.35°00'W. 3.50 "
N.10°00'W. 4.00 "
N.45°00'E. 0.97 " M.P. N. bd'y. 6.
Right bk. N. Fork. dn. stream.
South 2.00 "
S.17°30'E. 3.50 "
S.28°00'E. 3.20 "
S.45°00'W. 2.00 "
S.55°00'W. 1.30 "
S.80°00'W. 4.50 "
S.64°00'W. 3.70 " Mouth of N. Fork.
N. 9°00'E. 5.00 "
N.18°00'E. 1.50 "
N.11°00'E. 5.00 "
N. 4°00'E. 1.40 " M.P. N. bd'y. 6.
From M.P. N. bd'y. 6.
S.51°00'W. 3.50 "
S.60°00'W. 2.00 "
S.50°00'W. 6.00 "
S.53°00'W. 1.14 " M.P. West bd'y. 6.
Total 852.66

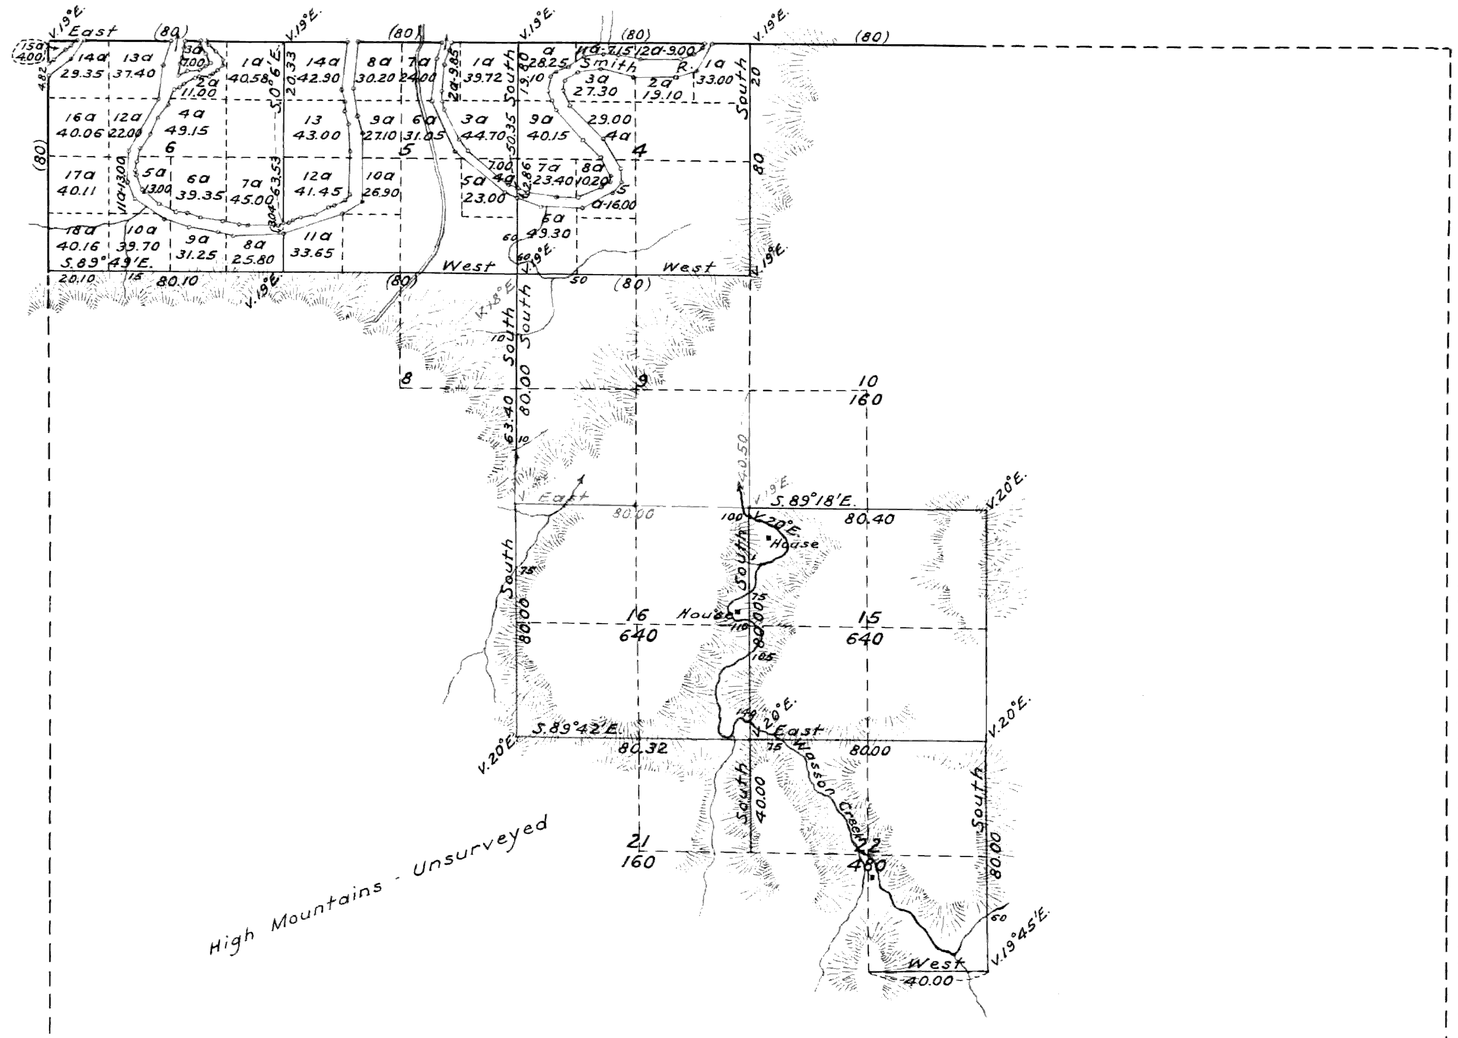

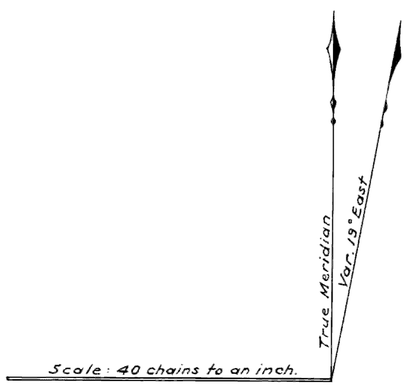

Scale: 40 chains to an inch.

Meanders of left bank of Smith's River from post on West bd'y. of Sec. 6, up stream.

N.50°00'E. 10.00 Chs.
N.47°00'E. 3.12 " Post on N. bd'y. Sec. 6
From post on left bk, Sec. 6, N. bd'y.
S.20°00'W. 9.00 "
S. 9°00'W. 12.00 "
S.30°00'W. 20.00 "
S. 5°00'W. 11.00 "
S.25°00'E. 6.00 "
S.55°00'E. 12.00 "
S.72°00'E. 9.00 "
S.80°00'E. 6.00 "
S.85°00'E. 4.00 "
S.75°00'E. 6.00 "
East 18.00 " Post bet. Sec's. 5 & 6.
From M.P. left bk, bet Sec's. 5 & 6
N.70°00'E. 21.00 "
N.60°00'E. 8.00 "
North 24.00 "
N.15°00'W. 6.00 "
N. 6°00'W. 10.00 "
N. 4°00'E. 16.40 " M.P. on N. bd'y. Sec. 5.
From M.P. left bk, N. bd'y. 5.
S.20°00'W. 6.00 "
S. 5°00'W. 15.00 "
S.25°00'E. 19.00 "
S.50°00'E. 22.00 "
S.67°00'E. 4.20 " M.P. bet. 4 & 5.
S.70°00'E. 9.00 "
East 14.00 "
N.63°00'E. 12.00 "
N.37°00'E. 4.00 "
North 5.00 "
N.30°00'W. 12.00 "
N.45°00'W. 16.00 "
N.27°00'W. 6.00 "
N.10°00'E. 4.00 "
N.55°00'E. 5.00 "
N.80°00'E. 8.00 "
S.75°00'E. 12.00 "
East 14.00 "
N.75°00'E. 8.00 "
N.26°00'E. 8.75 " M.P. N. bd'y. 4
From M.P. on right bank N. bd'y. 4.
S. 5°00'W. 1.13 "
S.50°00'W. 4.00 "
S.75°00'W. 4.00 "
West 14.00 "
N.75°00'W. 8.00 "
N.83°00'W. 5.00 "
S.80°00'W. 6.50 "
S.55°00'W. 6.00 "
S.75°00'W. 4.00 "
S.50°00'W. 2.00 "
S.10°00'W. 5.80 "
S.20°00'E. 3.00 "
S.27°00'E. 3.40 "
S.40°00'E. 13.40 "
S.46°00'E. 8.00 "
S.30°00'E. 7.70 "
South 1.50 "
S.37°00'W. 5.00 "
S.62°30'W. 9.00 "
West 7.30 "
N.80°00'W. 11.00 "
N.70°00'W. 3.00 " M.P. bet. 4 & 5.
N.65°00'W. 2.83 "
N.50°00'W. 18.00 "
N.40°30'W. 5.00 "
N.25°00'W. 12.00 "
N.10°00'W. 2.50 "
N. 7°00'W. 2.50 "
N. 5°00'E. 10.00 "
N.20°00'E. 6.00 "
North 2.00 " M.P. N. bd'y. 5.
From M.P. N. bd'y. 5.
S. 3°30'W. 16.00 "
S.13°00'E. 5.00 "
South 3.00 "
S.15°00'E. 4.00 "
S. 6°00'E. 9.00 "
South 15.00 "
S.25°00'W. 2.00 "
S.60°00'W. 4.00 "
S.70°00'W. 2.00 "
S.62°00'W. 4.80 "
S.80°00'W. 5.00 "
S.70°00'W. 4.20 "
S.60°00'W. 1.50 "
S.74°00'W. 2.12 " M.P. bet. 5 & 6.

(continued in column to the left)

The above Map of the survey of Sec's. 10, 15, 16, 21 and 22, T. 21 S., R. 10 W., Will. Mer., Oregon, is strictly conformable to the original field notes of the survey thereof on file in this Office, which have been examined and approved.

U.S. Surveyor General's Office,
Portland, Oregon,
March 26, 1880.

(signed) James C. Tolman.
Sur. General's Office.

Acres 480.00

Lines	Contractor	Contract No.	Contract Date	Am't. Surveyed Miles	Chains	Links	When Completed
Subdivisions	Jno. W. Meldrum	116	Dec'r. 12, 1866	6	63	63	
Meanders	" " "	"	" " "	10	52	66	March 4, 1867
Subdivisions	W. M. Byars	202	March 11th 1874	2	40	50	August 11th 1874
Total Acres	2095.28		Blue lines indicate	new Surveys			Nov. 19, 1879
Subdivisions Sec's.	10, 15, 16, 21 & 22 - Wm Thiel	342	Oct. 6, 1879	8	00	72	" 25, 1879

The above map of T. 21 S., R. 10 West, Will. Mer., Oregon, is strictly conformable to the original field notes of the Survey thereof on file in this office, which have been examined and approved.

Surveyor General's Office,
Eugene City, Sep. 28, 1867.

Total Acres 2080.00 Thiel Survey. (signed) E. L. Applegate.
Sur. Gen. of Oregon.

Public Survey Office,
Portland, Oregon,
September 9, 1935.
I certify this to be a correct copy of the original plat on file in this office.

Joseph A. Gaunt
Office Cadastral Engineer.

B.L.F. Copy.