1563

ORIGINAL

TOWNSHIP 21 SOUTH, RANGE 11 WEST, OF THE WILLAMETTE MERIDIAN, OREGON.

DEPENDENT RESURVEY AND PARTIAL SUBDIVISION

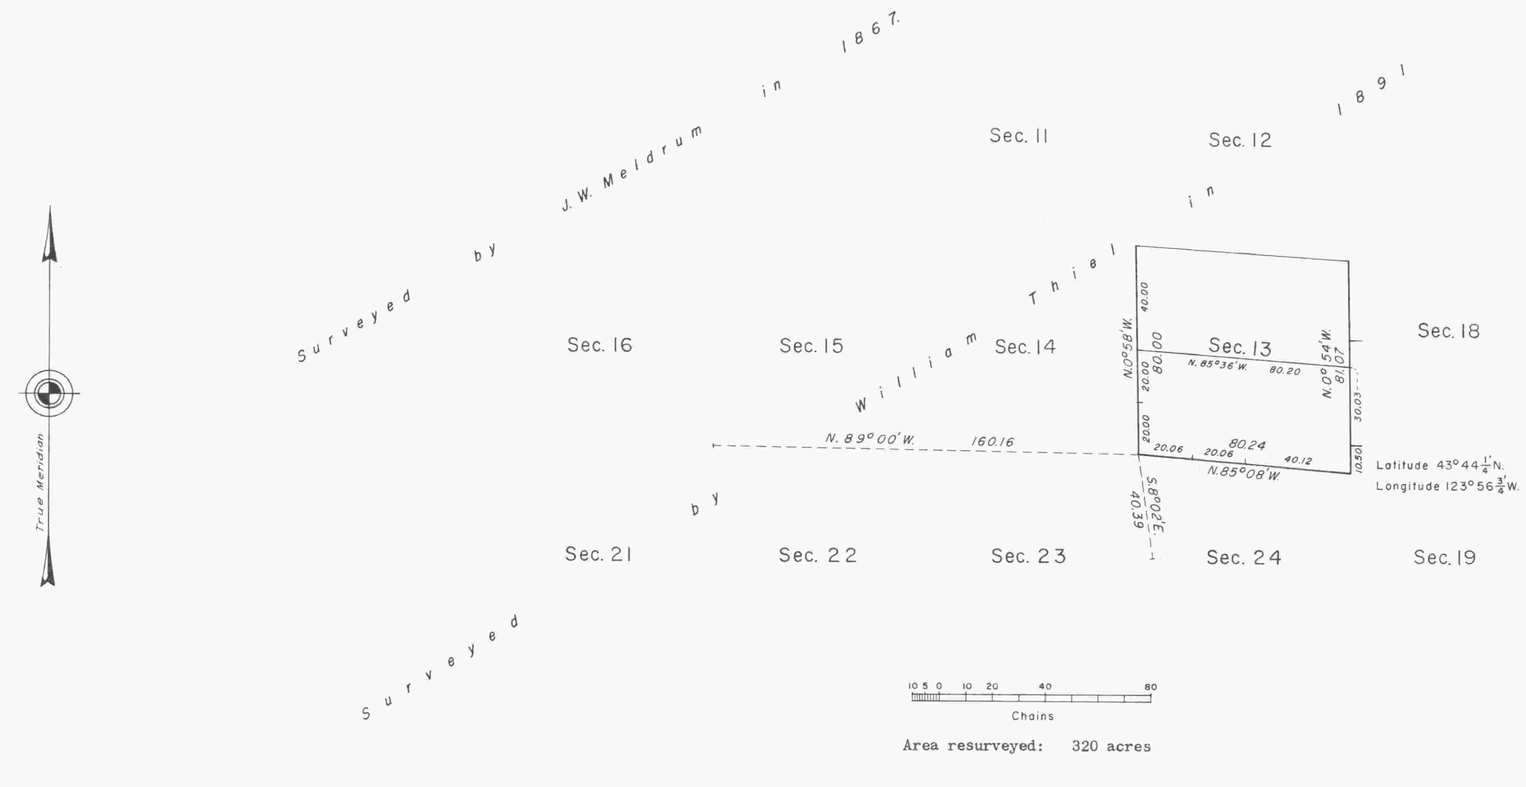

Area resurveyed: 320 acres

This plat represents a retracement and reestablishment of a portion of the subdivisional lines designed to restore the corners in their true original location according to the best available evidence.

Subdivisional lines surveyed by William Thiel in 1891.

Dependent resurvey of the west and south boundaries and survey of the east-west center line of section 13, T. 21 S., R. 11 W., Willamette Meridian, Oregon, executed by Thomas A. Tillman, August 28 to September 20, 1957, under Special Instructions dated August 6, 1957, which provide for the surveys included under Group No. 373, Oregon.

Timber in this area consists of Douglas fir, hemlock, western red cedar, Oregon maple, and alder.

UNITED STATES DEPARTMENT OF THE INTERIOR
BUREAU OF LAND MANAGEMENT
Washington, D. C. January 23, 1958

This plat is strictly conformable to the approved field notes, and the survey, having been correctly executed in accordance with the requirements of law and the regulations of this Bureau, is hereby accepted.

For the Director

Earl B. Harrington

Cadastral Engineering Staff Officer

GEW

T.M.H