TOWNSHIP 21 SOUTH, RANGE 11 WEST, OF THE WILLAMETTE MERIDIAN, OREGON

DEPENDENT RESURVEY AND SUBDIVISION OF SECTIONS 15, 31, AND 32

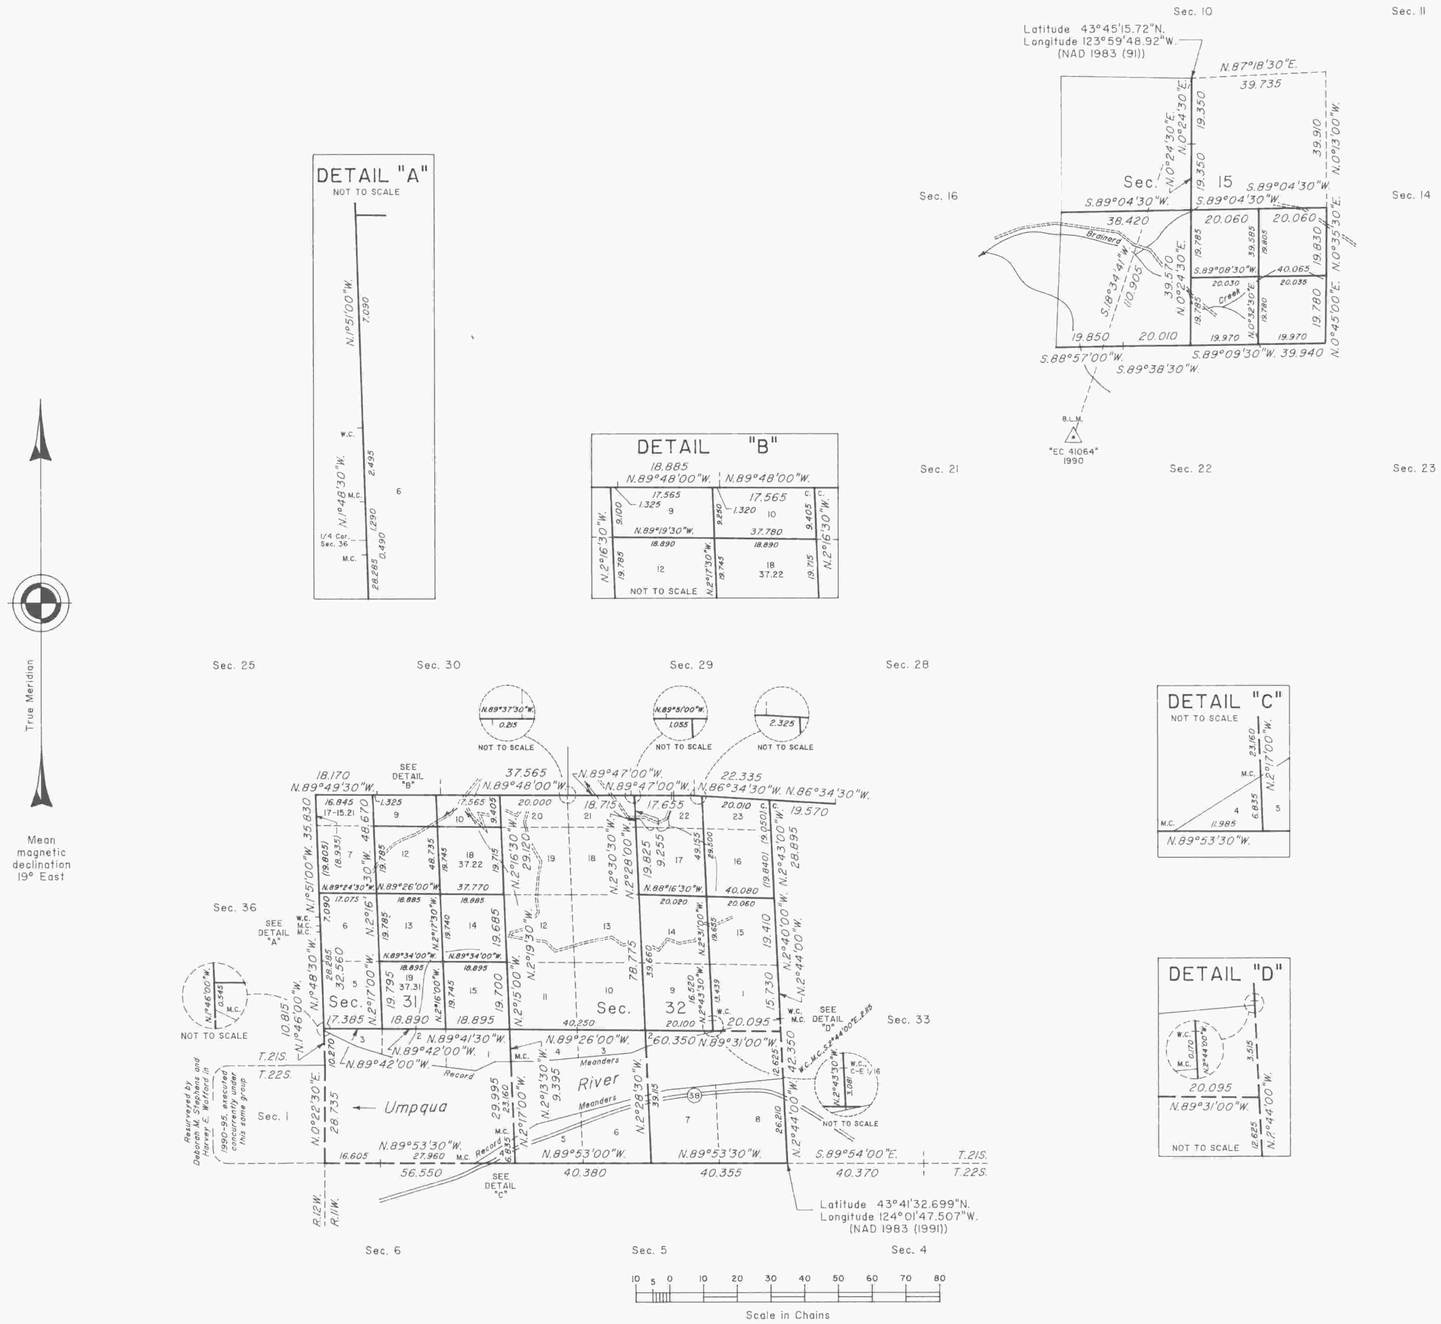

A history of surveys is contained in the field notes.

This plat represents a dependent resurvey of a portion of the south and west boundaries, and subdivisional lines, T. 21 S., R. 11 W., Willamette Meridian, Oregon, designed to restore the corners in their true original locations according to the best available evidence, and the subdivision of sections 15, 31 and 32.

Except as shown hereon, the lottings and areas are as shown on the plat approved August 2, 1875 and May 6, 1893.

The survey was executed by Deborah M. Stephens and Harvey E. Wotford, Cadastral Surveyors, beginning April 9, 1990, and completed April 3, 1995, pursuant to Special Instructions dated January 8, 1990, and Supplemental Special Instructions dated April 11, 1991, under Group Number 1521, Oregon.

Timber in this area consists of alder, cedar, fir, hemlock, maple, myrtle, madrone, and spruce.

The tie to the geodetic control station is reported as mean bearing and sea level distance.

UNITED STATES DEPARTMENT OF THE INTERIOR
BUREAU OF LAND MANAGEMENT

Portland, Oregon May 23, 1996

This plat is strictly conformable to the approved field notes, and the survey, having been correctly executed in accordance with the requirements of law and the regulations of this Bureau, is hereby accepted.

For the Director

Wayne A. Gardner

Chief Cadastral Surveyor of Oregon

D.F.B.