# Township No. 22 South Range No. 4 West of the Willamette Meridian Oregon.

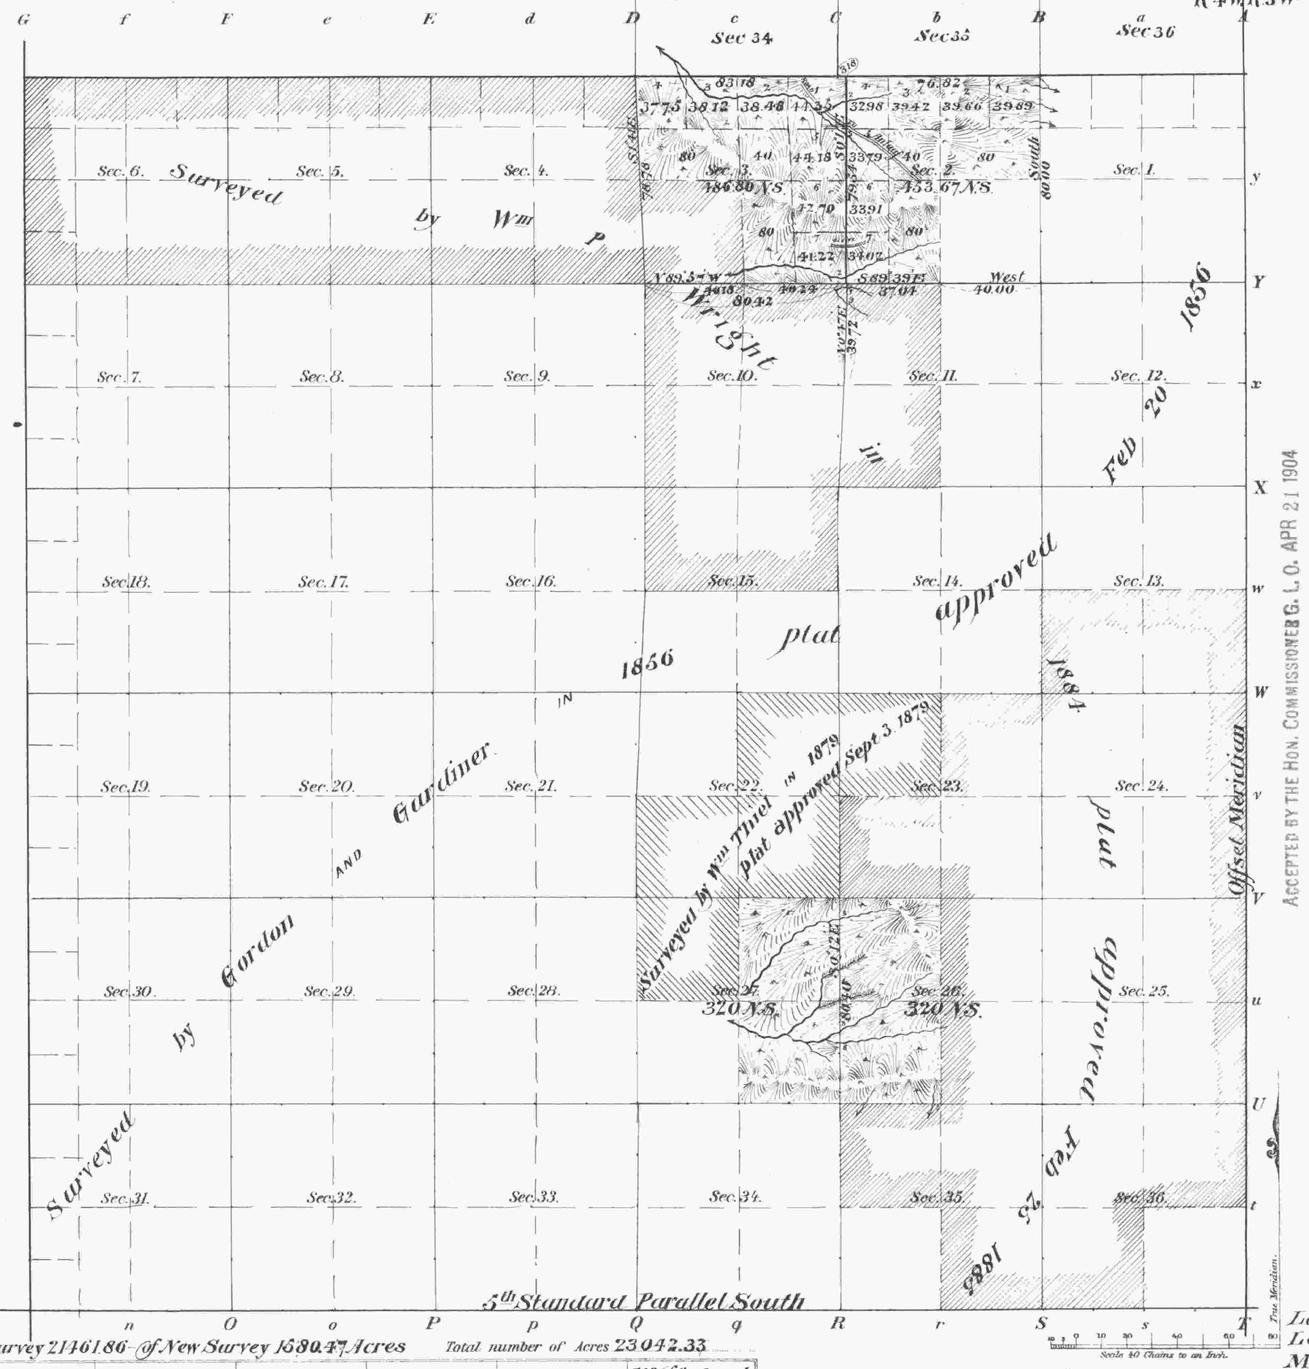


Meanders of

| Posts | Courses | Ch.s Lk.s | Posts | Courses | Ch.s Lk.s | Posts | Courses | Ch.s Lk.s |
|---|---|---|---|---|---|---|---|---|
| | | | | | | | | |

ACCEPTED BY THE HON. COMMISSIONER G. L. O. APR 21 1904

The above Map of T. 22 S. R. 4 W. Will Mer. Oregon, has been amended and is strictly conformable to the retracement of the line between Secs. 3 and 10 and of the original Survey thereof on file in this Office, which have been examined and approved
Surveyor Generals Office
Portland, Oregon May 20 1903
Jno D Daly
Sur. Gen'l for Oregon

Latitude 43° 37' N
Longitude 123° 7' W
Mean Mag Dec. 21° 25' E
At cor to Secs 26 and 27, 33 and 34

Area of Former Survey 21461.86 of New Survey 1580.47 Acres Total number of Acres 23042.33

| Surveys Designated | By Whom Surveyed | Date of Contract | Amount of Surveys M | Ch.s | Lk.s | When Surveyed | No. of Contract |
|---|---|---|---|---|---|---|---|
| Township lines | | | | | | | |
| Subdivisions | Oscar F Thiel | August 15. 1901 | 2. | 36. | 98 | Nov.r 8 to 13. 1901 | Special Instructions |
| Connections | " " " | " " " | | 3. | 18 | " | " |
| Retracements | " " " | " " " | 1 | 40. | 14 | " | " |
| North & West Bdries of Tp | Gardner & Gordon | Feb 17th 1855 | | | | 1855 | 52 |
| South and East Bdries of Tp | James E Freeman | May 28. 1851 | | | | 1851 | 1 |

The above Map of Township No. 22 South of Range No. 4 West of the Willamette Meridian, Oregon is strictly conformable to the field notes of the survey thereof on file in this Office, which have been examined and approved.

Surveyor Generals Office,
Portland Oregon July 14. 1902

Henry Meldrum
Sur. Gen'l for Oregon