ORIGINAL

FILED
Date: 10/21/2009 By: JC
This survey consists of:
Map: VOL. 55 PAGES 21777-21822
Narrative:
Corner Rpt:
DOUGLAS COUNTY SURVEYOR

TOWNSHIP 22 SOUTH, RANGE 4 WEST, OF THE WILLAMETTE MERIDIAN, OREGON

DEPENDENT RESURVEY AND SUBDIVISION OF SECTIONS 21 AND 23

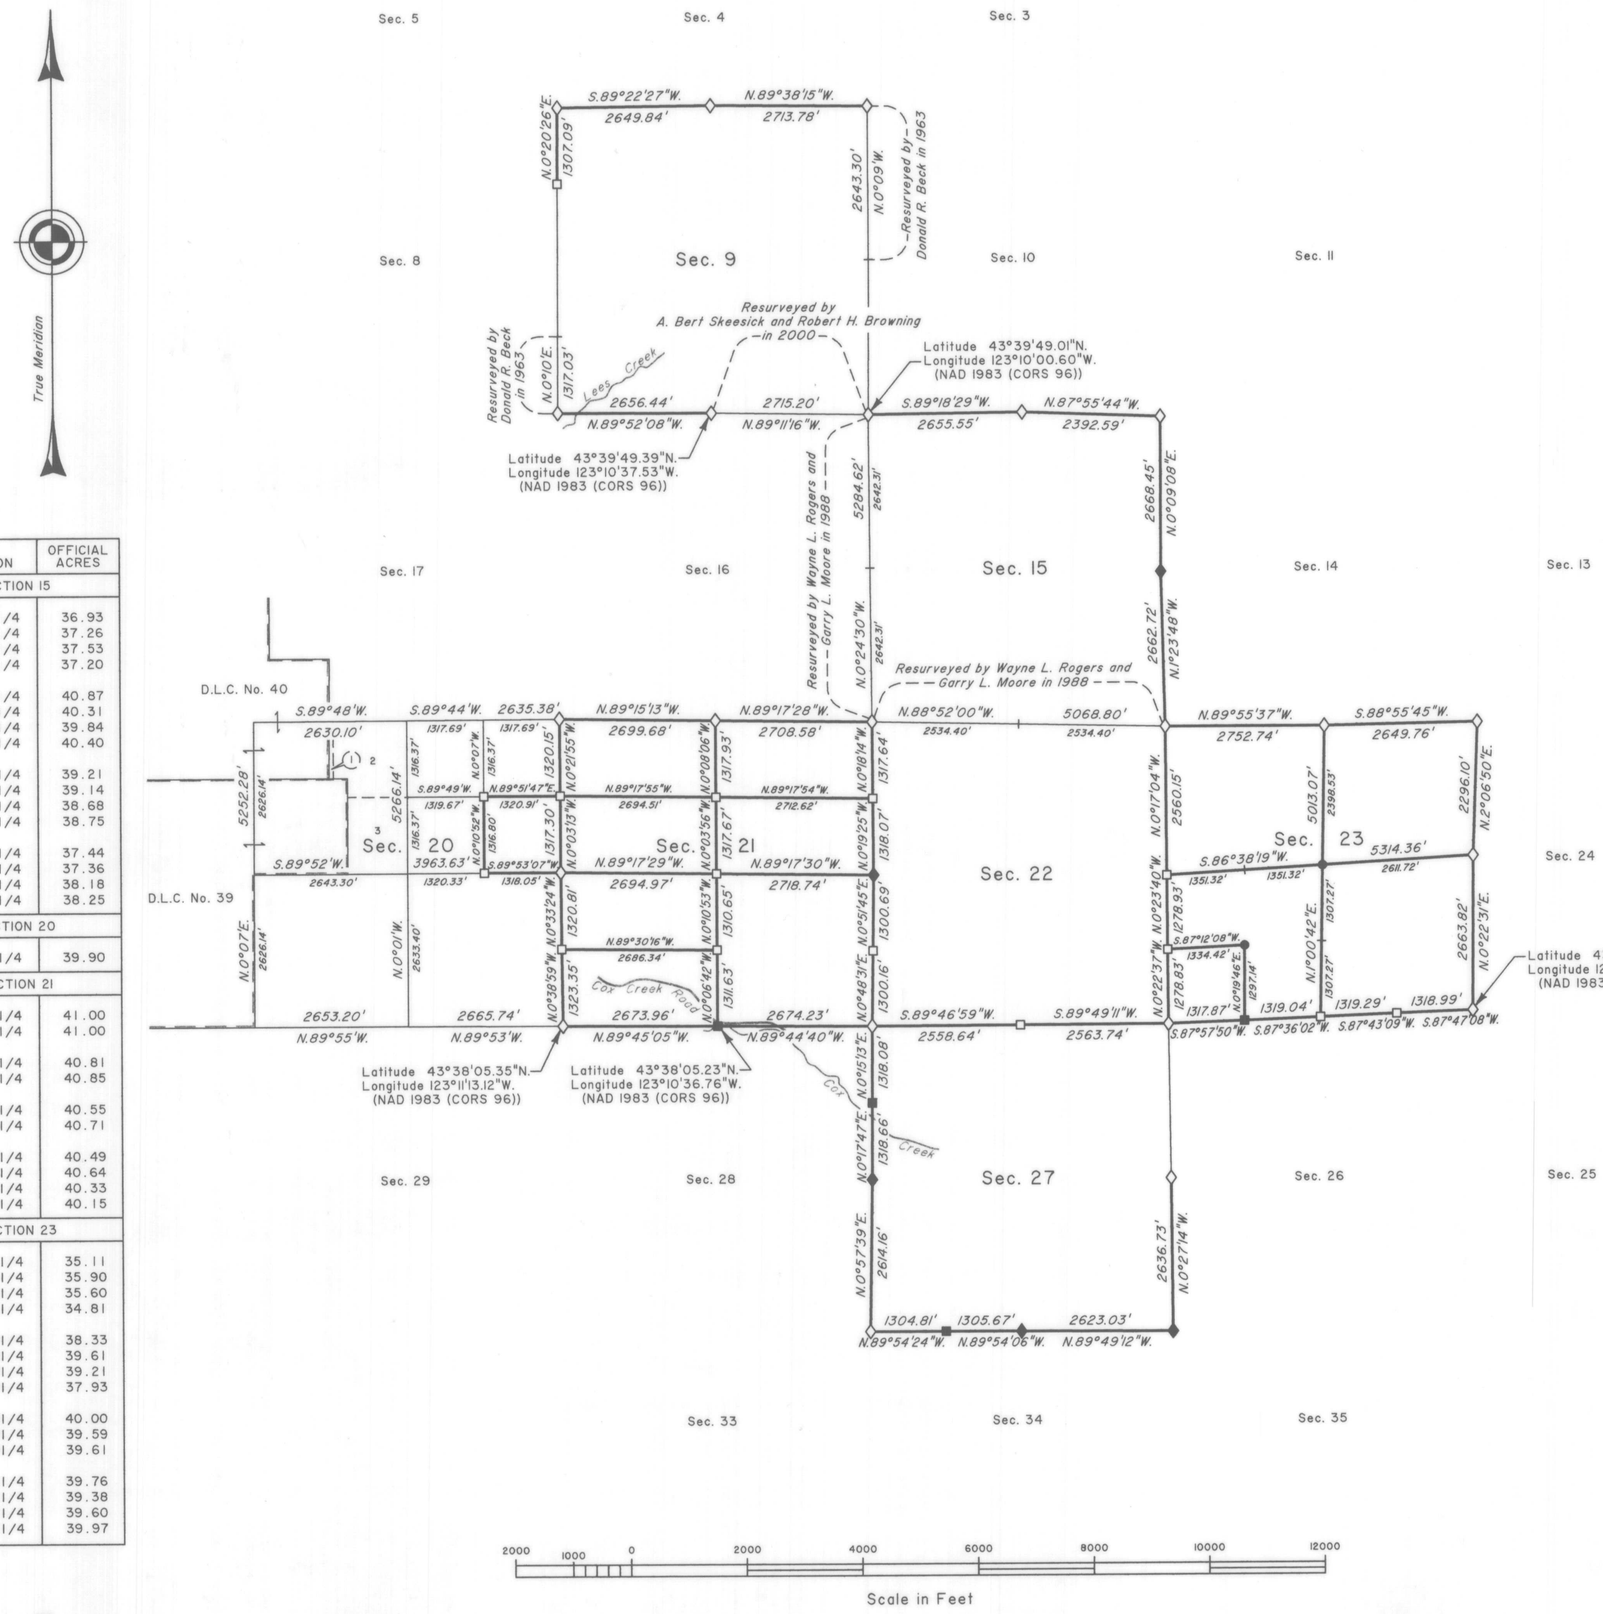

LEGAL SUBDIVISION	OFFICIAL ACRES
SECTION 15	
NE1/4 NE1/4	36.93
NW1/4 NE1/4	37.26
SW1/4 NE1/4	37.53
SE1/4 NE1/4	37.20
NE1/4 NW1/4	40.87
NW1/4 NW1/4	40.31
SW1/4 NW1/4	39.84
SE1/4 NW1/4	40.40
NE1/4 SW1/4	39.21
NW1/4 SW1/4	39.14
SW1/4 SW1/4	38.68
SE1/4 SW1/4	38.75
NE1/4 SE1/4	37.44
NW1/4 SE1/4	37.36
SW1/4 SE1/4	38.18
SE1/4 SE1/4	38.25
SECTION 20	
SE1/4 NE1/4	39.90
SECTION 21	
NE1/4 NE1/4	41.00
NW1/4 NE1/4	41.00
NE1/4 NW1/4	40.81
NW1/4 NW1/4	40.85
NE1/4 SW1/4	40.55
NW1/4 SW1/4	40.71
NE1/4 SE1/4	40.49
NW1/4 SE1/4	40.64
SW1/4 SE1/4	40.33
SE1/4 SE1/4	40.15
SECTION 23	
NE1/4 NE1/4	35.11
NW1/4 NE1/4	35.90
SW1/4 NE1/4	35.60
SE1/4 NE1/4	34.81
NE1/4 NW1/4	38.33
NW1/4 NW1/4	39.61
SW1/4 NW1/4	39.21
SE1/4 NW1/4	37.93
NE1/4 SW1/4	40.00
NW1/4 SW1/4	39.59
SE1/4 SW1/4	39.61
NE1/4 SE1/4	39.76
NW1/4 SE1/4	39.38
SW1/4 SE1/4	39.60
SE1/4 SE1/4	39.97

A history of surveys is contained in the field notes.

This plat represents a dependent resurvey of a portion of the subdivisional lines and a portion of the subdivision of section lines of section 20, T. 22 S., R. 4 W., Willamette Meridian, Oregon, designed to restore the corners in their true original locations according to the best available evidence, and the subdivision of sections 21 and 23.

Measured distances and directions have been adjusted by computer software that incorporates a least squares adjustment routine. The adjusted bearings and distances are reported to the nearest second and 0.01 foot.

Actual quantity acreages have been returned for federal interest lands where indicated. New official acreages for previously designated aliquot parts and lots are listed in tabular form. The location of such shall continue to be ascertained in accordance with the Manual. Where not indicated, official lot designations and acreages are as shown on the plats approved February 20, 1856, October 19, 1859, September 3, 1879, February 25, 1885, July 14, 1902, and as amened May 20, 1903. Areas assigned a lot number may be further subdivided only by supplemental plat or another official survey.

The survey was executed by A. Bert Skeesick, Cadastral Surveyor, and Robert H. Browning, Surveying Technician, beginning August 1, 2007, and completed February 19, 2008, pursuant to Special Instructions dated May 21, 2007, under Group Number 2170, Oregon.

Notes:

Lightweight exterior and subdivision of section lines of section 20 were surveyed by Donald R. Beck in 1963.

LEGEND

- ◇ Original corner previously remonumented
- ◆ Original corner remonumented this survey
- □ Corner previously established or reestablished
- ■ Corner previously established or reestablished; remonumented this survey
- ● Corner established this survey

UNITED STATES DEPARTMENT OF THE INTERIOR
BUREAU OF LAND MANAGEMENT

Portland, Oregon

This plat is strictly conformable to the approved field notes, and the survey, having been correctly executed in accordance with the requirements of law and the regulations of this Bureau, is hereby accepted.

For the Director

Mary J. M. Hunter

Chief Cadastral Surveyor of Oregon

July 16, 2009
Date