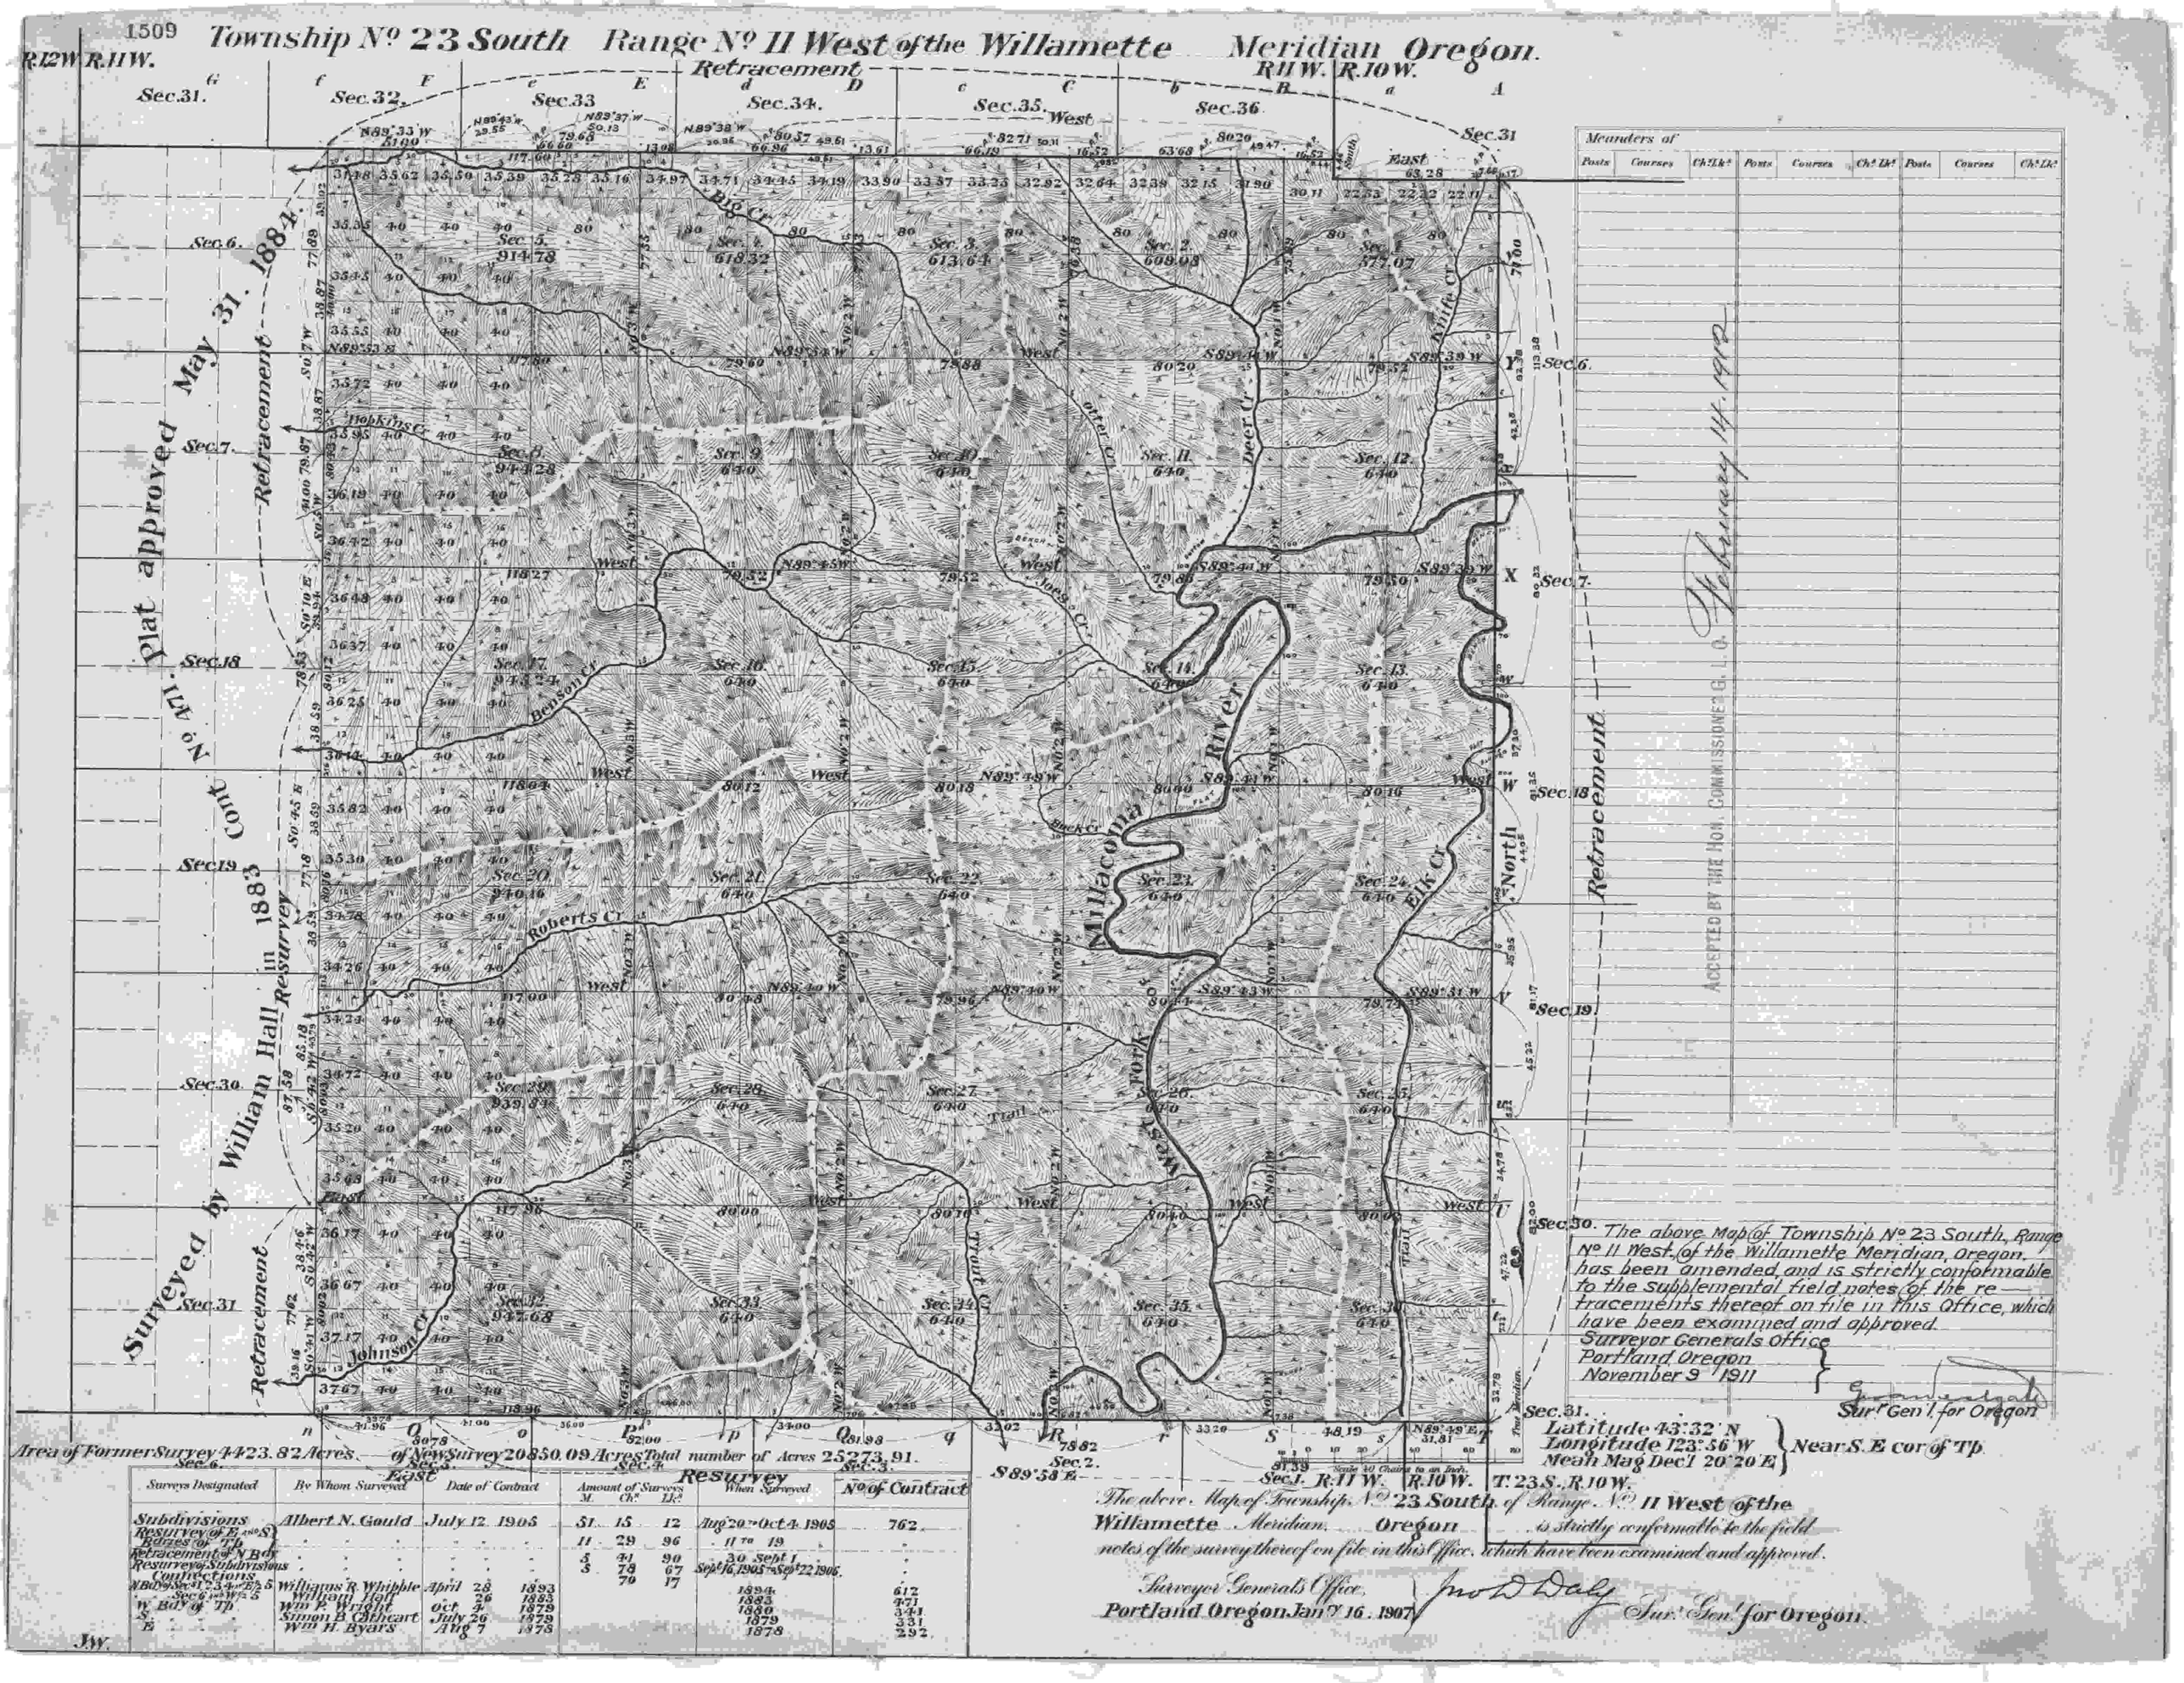

See e-mail dated Sept. 30, 2004, in CS File 63/166 (not scanned), concerning the 1/4 Cor. between Secs. 17 _18 (BLM is changing the corner to be a common corner)