1574

Township No. 22 South Range No. 12 West of the Willamette Meridian Oregon.

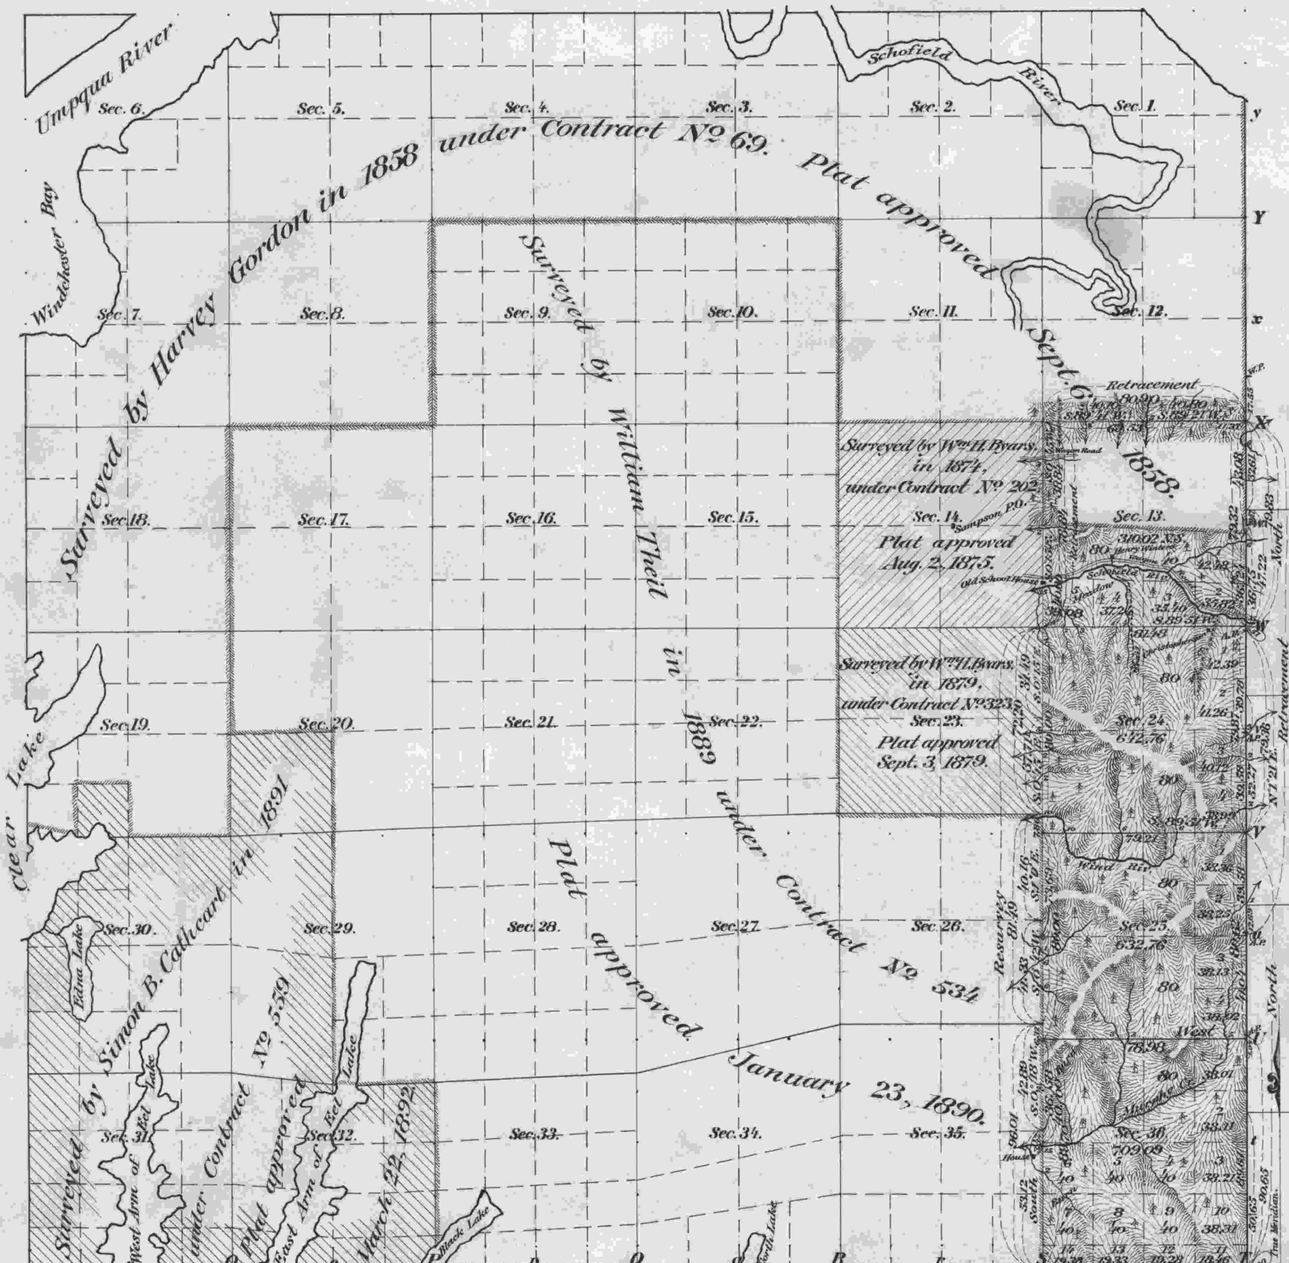

Surveys Designated	By Whom Surveyed	Date of Contract	Amount of Surveys M.	Ch.s	Lk.s	When Surveyed	No. of Contract
Township lines							
Subdivisions	Charles A. Slang.	Febry 17, 1910.	2	79	67	May 3 to 7, 1910.	793
Resurvey of Subd.ns	" " "	" " "	3	09	70	April 26 to 29 "	"
Retracement of "	" " "	" " "	1	79	74	" 27 - 30 "	"
" " E. Bdy. of Secs. 13, 24 and N.½ of Sec. 25.	" " "	" " "	2	38	77	May 2 - 3 "	"
Connections	" " "	" " "		62	18		"
E. Bdy. of Secs. 24, 25 and 36	Williams R. Whipple.	April 28, 1893.				1894	612
S. Bdy. of Township.	Wm P. Wright.	Oct. 7, 1879.				1880	321
W.m N.E. S.E. W. Bdries of Tp.	Harvey Gordon.	Febr 2, 1857.				1858	69

The above Map of Township No. 22 South of Range No. 12 West of the Willamette Meridian, Oregon, is strictly conformable to the field notes of the survey thereof on file in this office, which have been examined and approved.

Surveyor Generals Office,
Portland, Oregon Nov.r 12, 1910.

Sur. Gen. for Oregon.

THE NORRIS PETERS CO. LITHO. WASHINGTON, D. C.