235

Township N.o 23 South Range 2 West of the Willamette Meridian Oregon

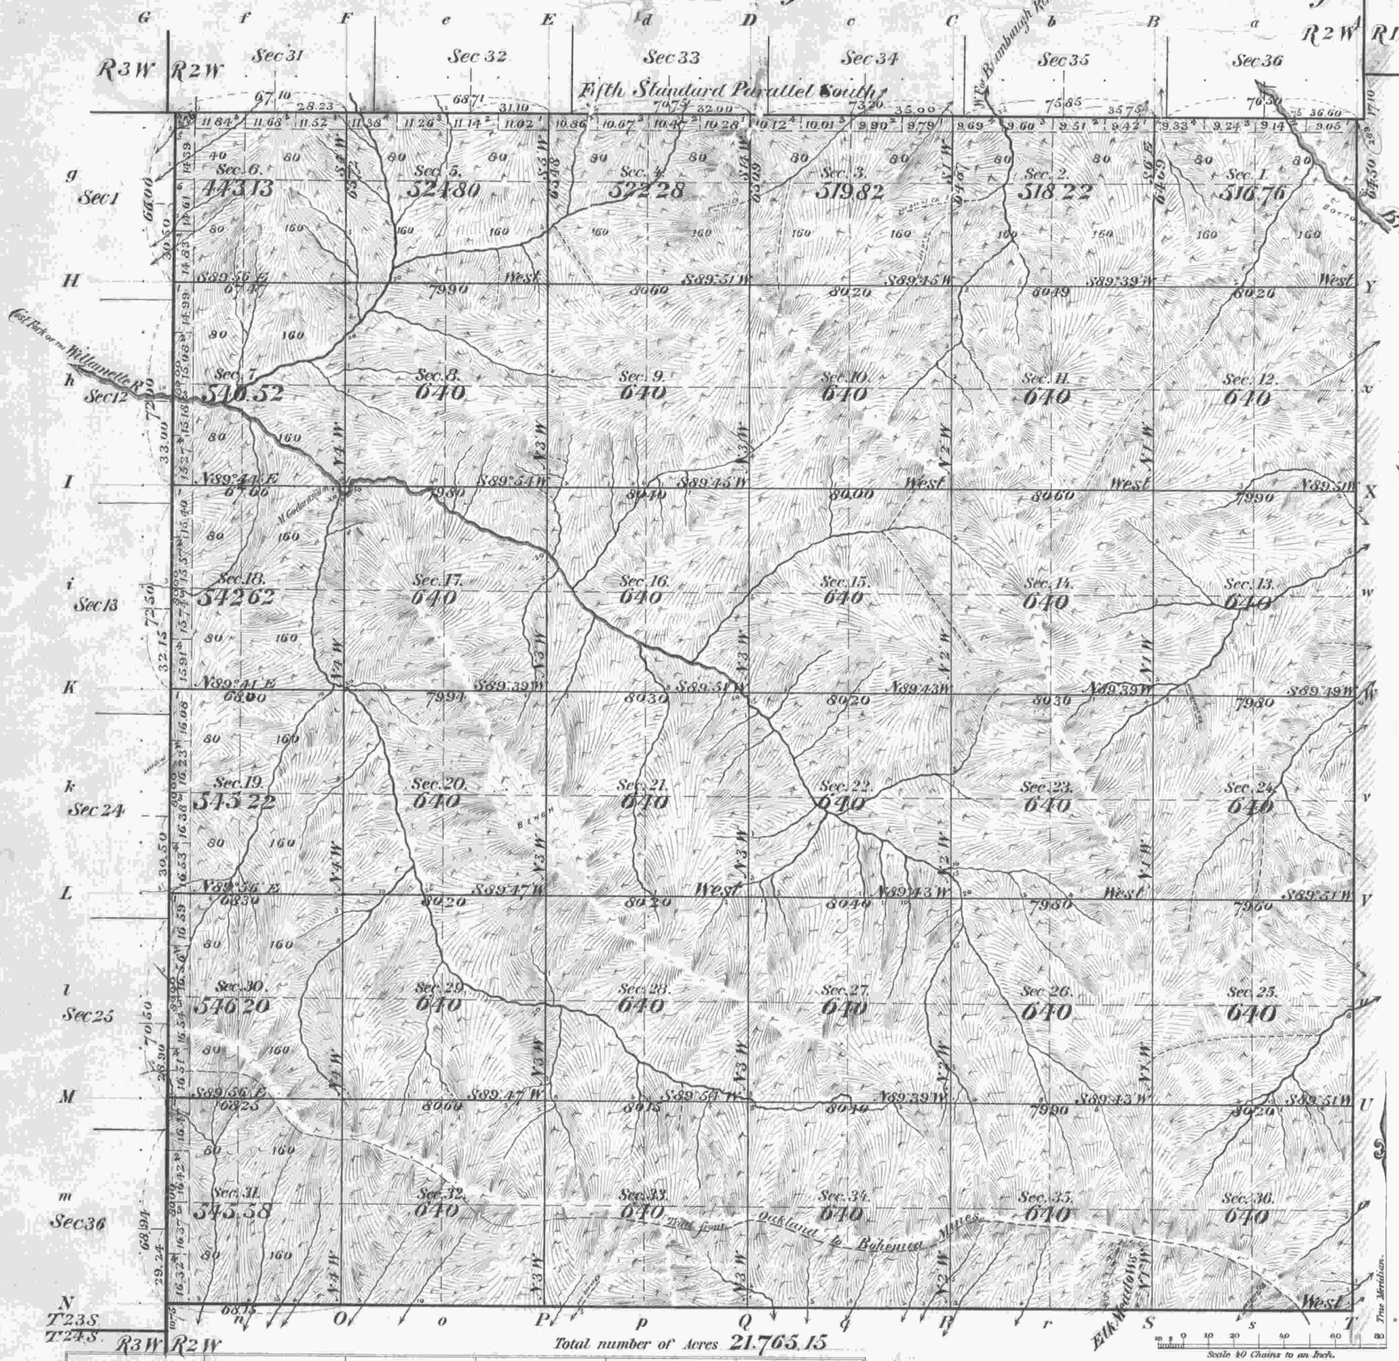

Total number of Acres 21.765.15

Meanders of								
Posts	Courses	Ch.s Lk.s	Posts	Courses	Ch.s Lk.s	Posts	Courses	Ch.s Lk.s

CASCADE FOREST RESERVE

Surveys Designated	By Whom Surveyed	Date of Contract	Amount of Surveys M.	Ch.s	Lk.s	When Surveyed	Mean Declination
Township lines	Henry L. Chandler	June 5 1893					
Subdivisions	" " "	" " "	58	29	57	Aug 12 to Sept 4 1894	17° 30' E
Resurvey of N.o W. Bdries	" " "	" " "	11	53	10	Aug 7 to 11 1894	
Connections	" " "	" " "					
Contract N.o 619							

The above Map, of Township N.o 23 South, of Range N.o 2 West of the Willamette Meridian, Oregon is strictly conformable to the field notes of the survey thereof on file in this Office, which have been examined and approved.

Surveyor General's Office,
Portland, Oregon, January 17 1895

John C. Arnold,
Sur.r Gen.l for Oregon