528 **Township No 23 South Range No 4 West of the Willamette Meridian Oregon**

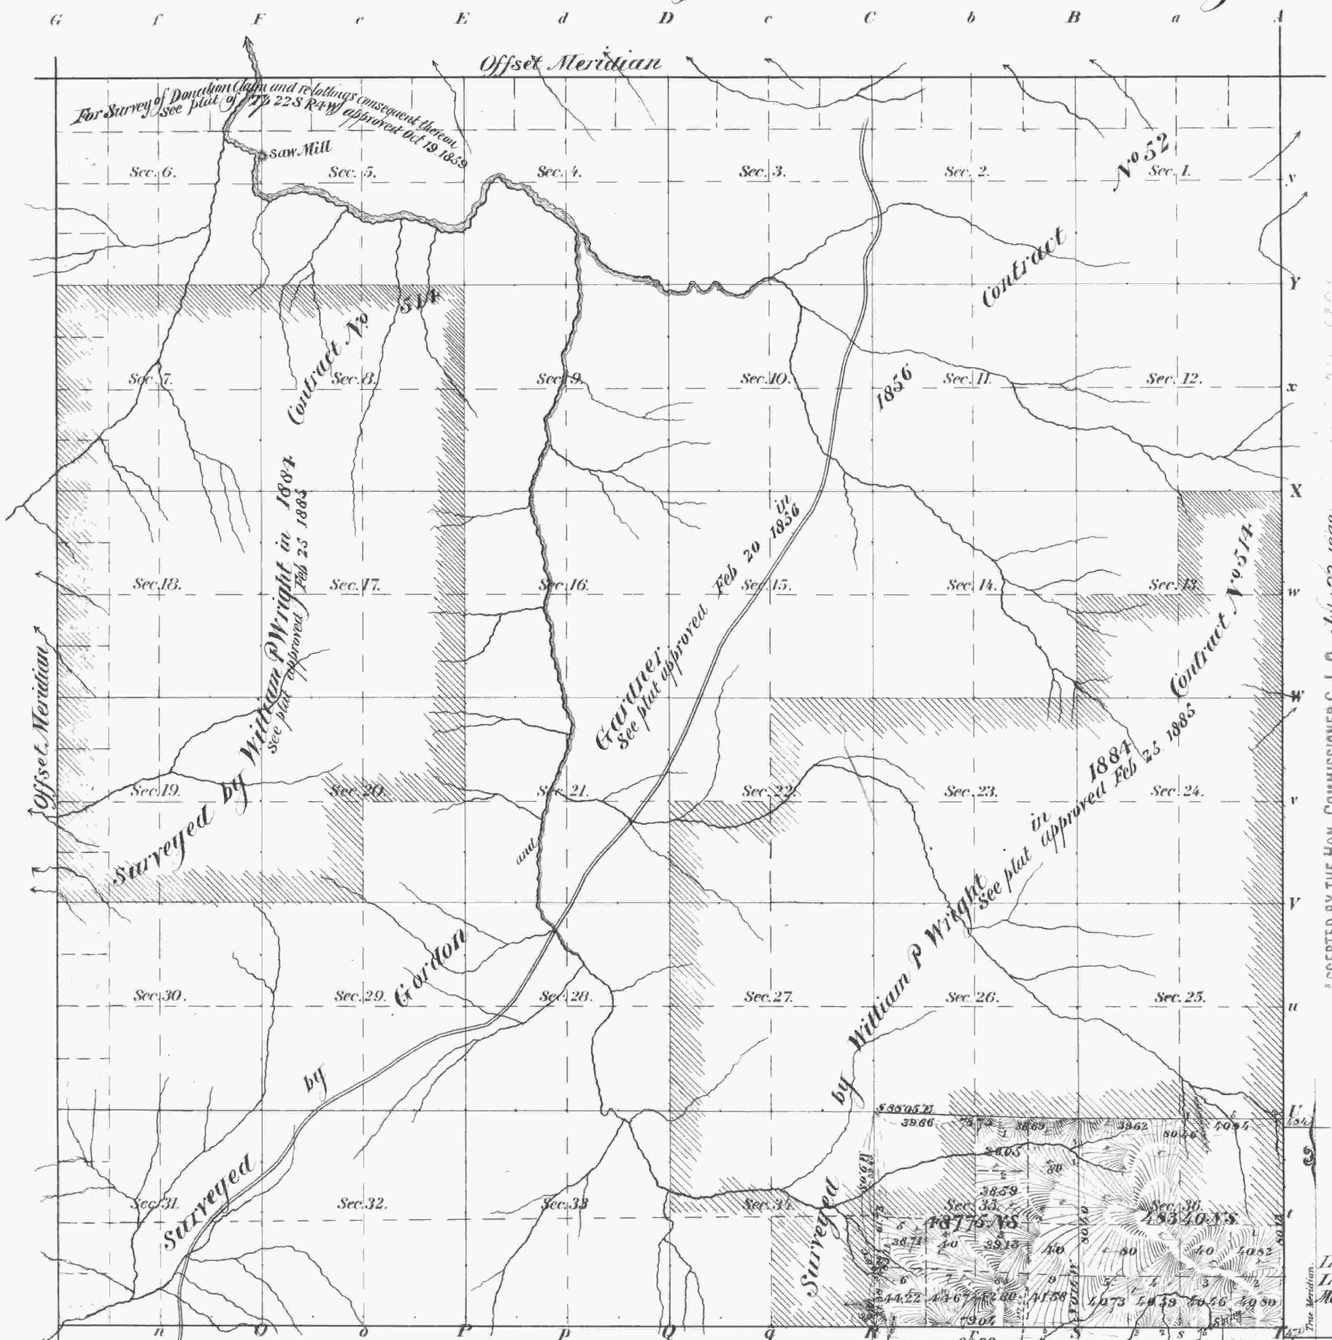

Latitude 43° 32' N
Longitude 123° 9' W of G } Near N W cor of Sec 34
Mean mag dec.t 19° 30' E

Area of Former Surveys 22283.44 Acres of New Survey 971.15 Acres Total number of Acres 23,254.59

Surveys Designated	By Whom Surveyed	Date of Contract	Amount of Surveys M.	Ch.s	Lk.s	When Surveyed	No of Contract
Township lines	W S Chapman and Carl S Nicklin	May 23 1896					664
S Bdry of Secs 35 36	" " "	" " "	1	62	62		"
Subdivisions	" " "	" " "		5	80		"
Connections							
North and West Bdries of T 23 South Bdry of Secs 31 32 33 & 34 East Bdry of Sec 1 T 24	Gordon and Gardner	Feb 17 1855				1855	52
	" " "	" " "				"	"

Meanders of

Posts	Courses	Ch.s Lk.s	Posts	Courses	Ch.s Lk.s	Posts	Courses	Ch.s Lk.s

ACCEPTED BY THE HON. COMMISSIONER G. L. O. July 22, 1898

Sec 2 Sec 1 R 4 W R 3 W

The above Map of Township No 23 South of Range No 4 West of the Willamette Meridian Oregon is strictly conformable to the field notes of the survey thereof on file in this Office, which have been examined and approved.

Surveyor Generals Office Portland Oregon Mar 25 1898

Robert A Habersham
Sur. Gen.l for Oregon