TOWNSHIP 23 SOUTH, RANGE 4 WEST, OF THE WILLAMETTE MERIDIAN, OREGON.

DEPENDENT RESURVEY AND SUBDIVISION OF SECTION 14

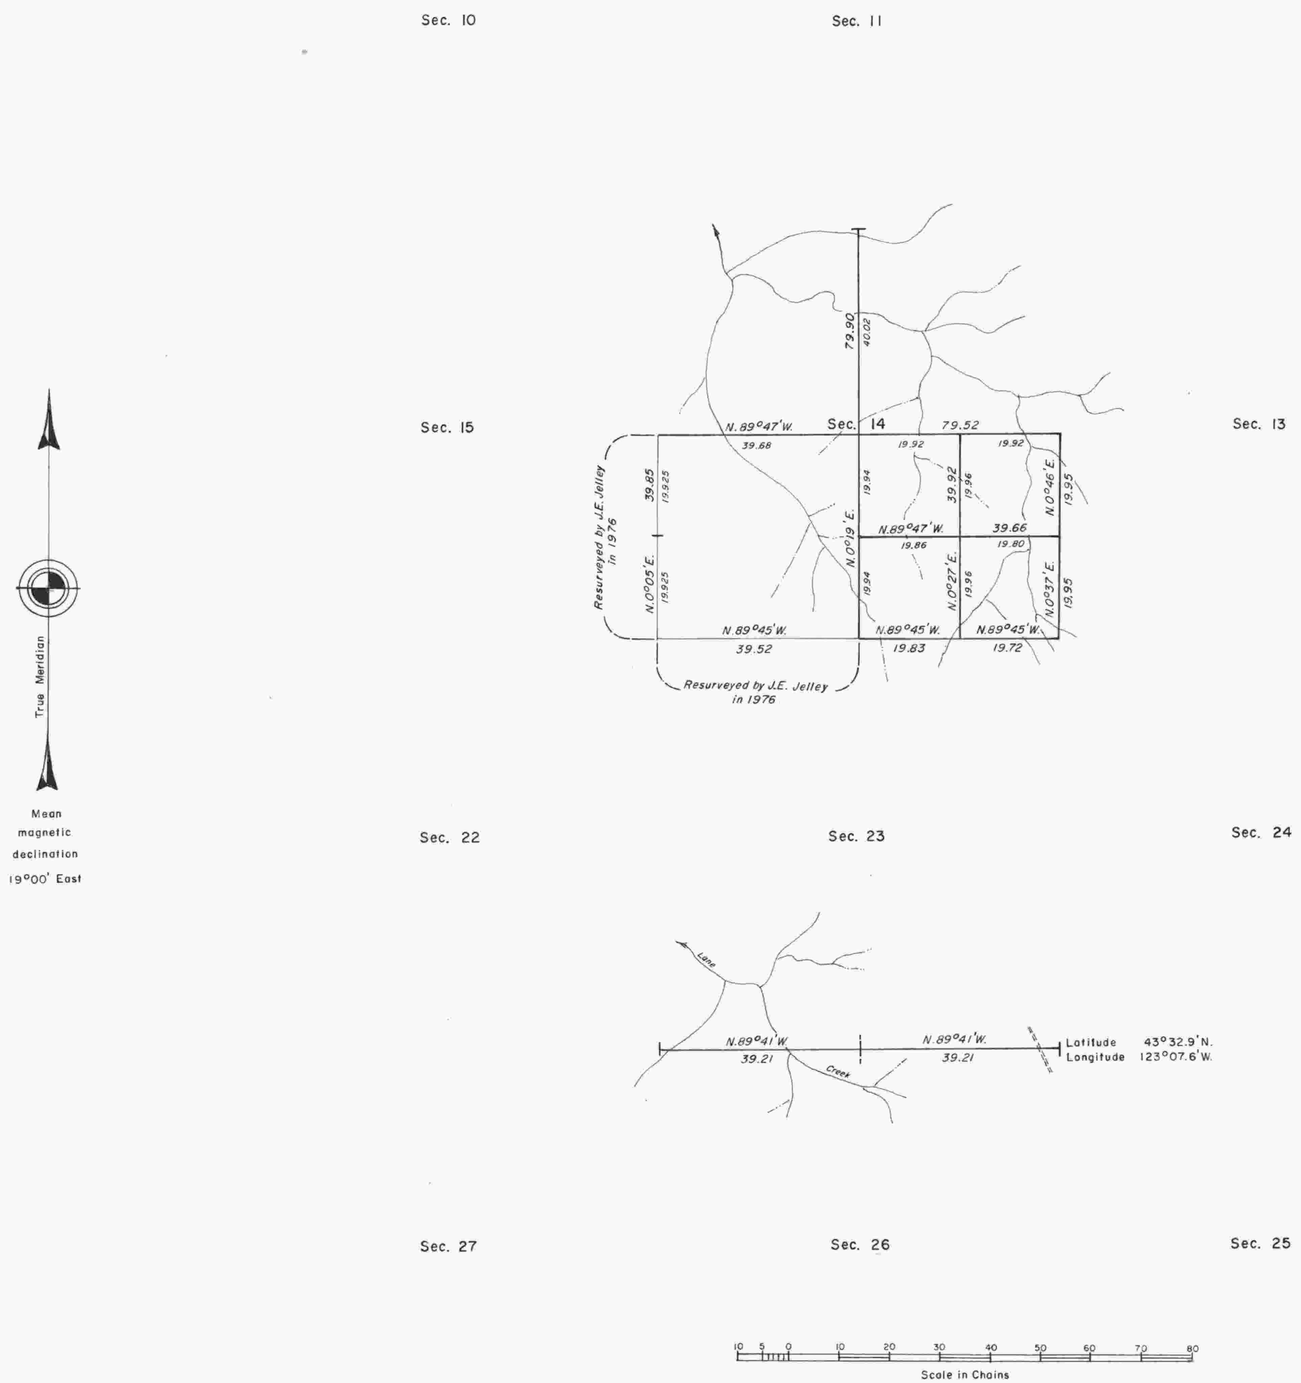

A history of surveys is contained in the field notes.

This plat represents a dependent resurvey of a portion of the subdivisional lines, T. 23 S., R. 4 W., Willamette Meridian, Oregon, and the subdivision of section 14.

The lottings and areas are as shown on the plats approved February 20, 1856 and February 25, 1885.

The survey was executed by James E. Jelley, Cadastral Surveyor, beginning November 5, 1981, and completed April 22, 1982, pursuant to Special Instructions dated October 28, 1981, for Group No. 1083, Oregon.

Timber in this area consists of ash, maple, fir, hemlock, madrone, yew, alder, cedar, and chinquapin.

UNITED STATES DEPARTMENT OF THE INTERIOR
BUREAU OF LAND MANAGEMENT
Portland, Oregon August 3, 1984

This plat is strictly conformable to the approved field notes, and the survey, having been correctly executed in accordance with the requirements of law and the regulations of this Bureau, is hereby accepted.

For the Director

William W. Glenn

Chief Cadastral Surveyor of Oregon

gee