TOWNSHIP 23 SOUTH, RANGE 8 WEST, OF THE WILLAMETTE MERIDIAN, OREGON

CORRECTIVE DEPENDENT RESURVEY AND SURVEY, DEPENDENT RESURVEY, AND SUBDIVISION OF SECTION 28

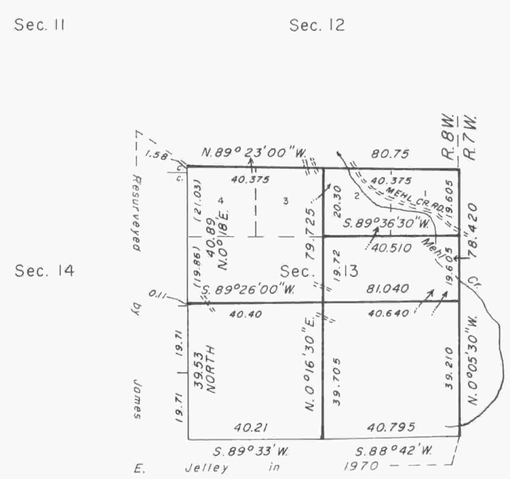

Sec. 20 Sec. 21 Sec. 22 Sec. 23 Sec. 24 Sec. 19

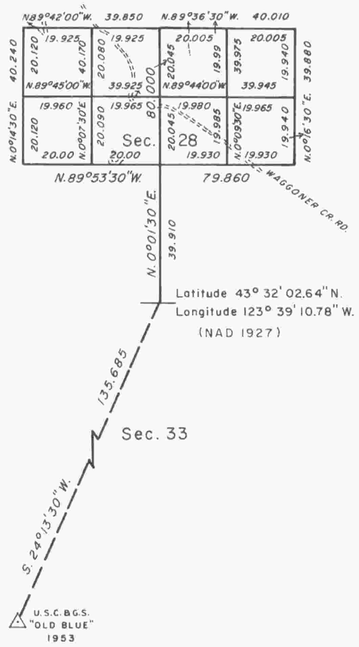

Sec. 29 Sec. 27

Sec. 32 Sec. 33 Sec. 34

The history of surveys is contained in the field notes.

This plat represents a corrective dependent resurvey of a portion of the east boundary and subdivisional lines, the corrective survey of the subdivision of section lines of section 13, and the dependent resurvey of a portion of the subdivisional lines, T. 23 S., R. 8 W., Willamette Meridian, Oregon, designed to restore the corners in their true original locations according to the best available evidence, and the subdivision of section 28.

The lottings and areas are as shown on the plat approved June 27, 1895.

The survey was executed by John A. Farmer, Cadastral Surveyor, beginning August 4, 1986, and completed October 15, 1986, pursuant to Special Instructions dated July 10, 1986, under Group Number 1336, Oregon.

Timber in this area consists of fir, cedar, hemlock, alder, madrone, maple, and myrtle.

UNITED STATES DEPARTMENT OF THE INTERIOR
BUREAU OF LAND MANAGEMENT
Portland, Oregon September 30, 1988

This plat is strictly conformable to the approved field notes, and the survey, having been correctly executed in accordance with the requirements of law and the regulations of this Bureau, is hereby accepted.

For the Director

Wayne M. Gardner

Chief Cadastral Surveyor of Oregon

USA