Township No. 23 South Range No. 9 West of the Willamette Meridian Oregon

1264

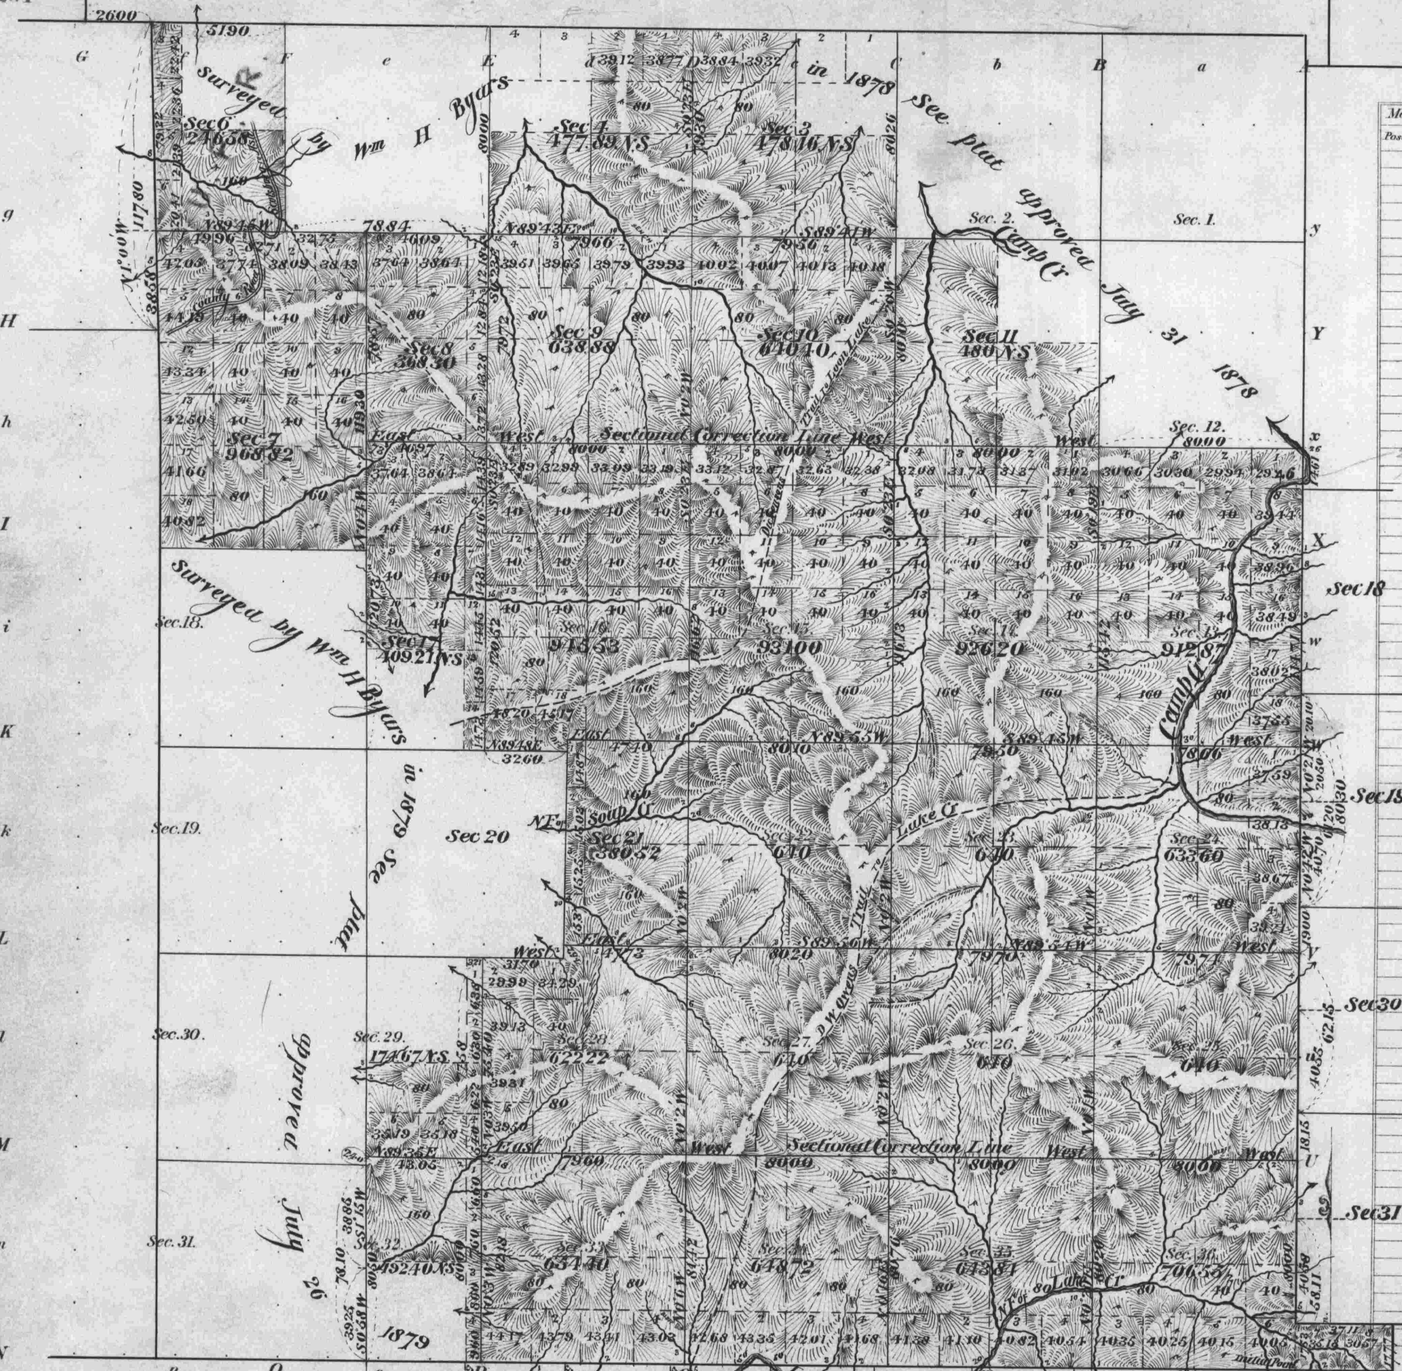

Meanders of

Posts	Courses	Ch.s Lk.s	Posts	Courses	Ch.s Lk.s	Posts	Courses	Ch.s Lk.s

ACCEPTED BY THE HON. COMMISSIONER G. L. O. January 31, 1901

Area of Former Surveys 670.31 Acres — of New Survey 15,324.66 Acres — Total number of Acres 22,032.97

Surveys Designated	By Whom Surveyed	Date of Contract	Amount of Surveys M.	Ch.s	Lk.s	When Surveyed	No. of Contract
Township lines Resurvey of Secs 33 34 & 35 Subdivisions	Oscar F Thiel	June 9	1898	40	55	60	Aug 21-1898 to June 5 1899	688
Connections	" " "	" "	"	1	43	47	"
Retracements				3	47	01	
N B'd'y of T and E B'd'y of Secs 1 and 12	William H Byars	Mar 6	1878				1878	279
West S Boundary of Tp	" " "	Aug 7	1878				1878	292
E B'd'y of Secs 13 24 25 and 36	Wm R Whipple	June 23	1893				1894	622

The above Map of Township No. 23 South of Range No. 9 West of the Willamette Meridian Oregon is strictly conformable to the field notes of the survey thereof on file in this Office, which have been examined and approved.

Surveyor General's Office
Portland Oregon June 12 1900

Robert A. Habersham
Sur. Gen'l for Oregon