TOWNSHIP 23 SOUTH, RANGE 9 WEST, OF THE WILLAMETTE MERIDIAN, OREGON.

DEPENDENT RESURVEY AND SUBDIVISION OF SECTION 2 AND 13

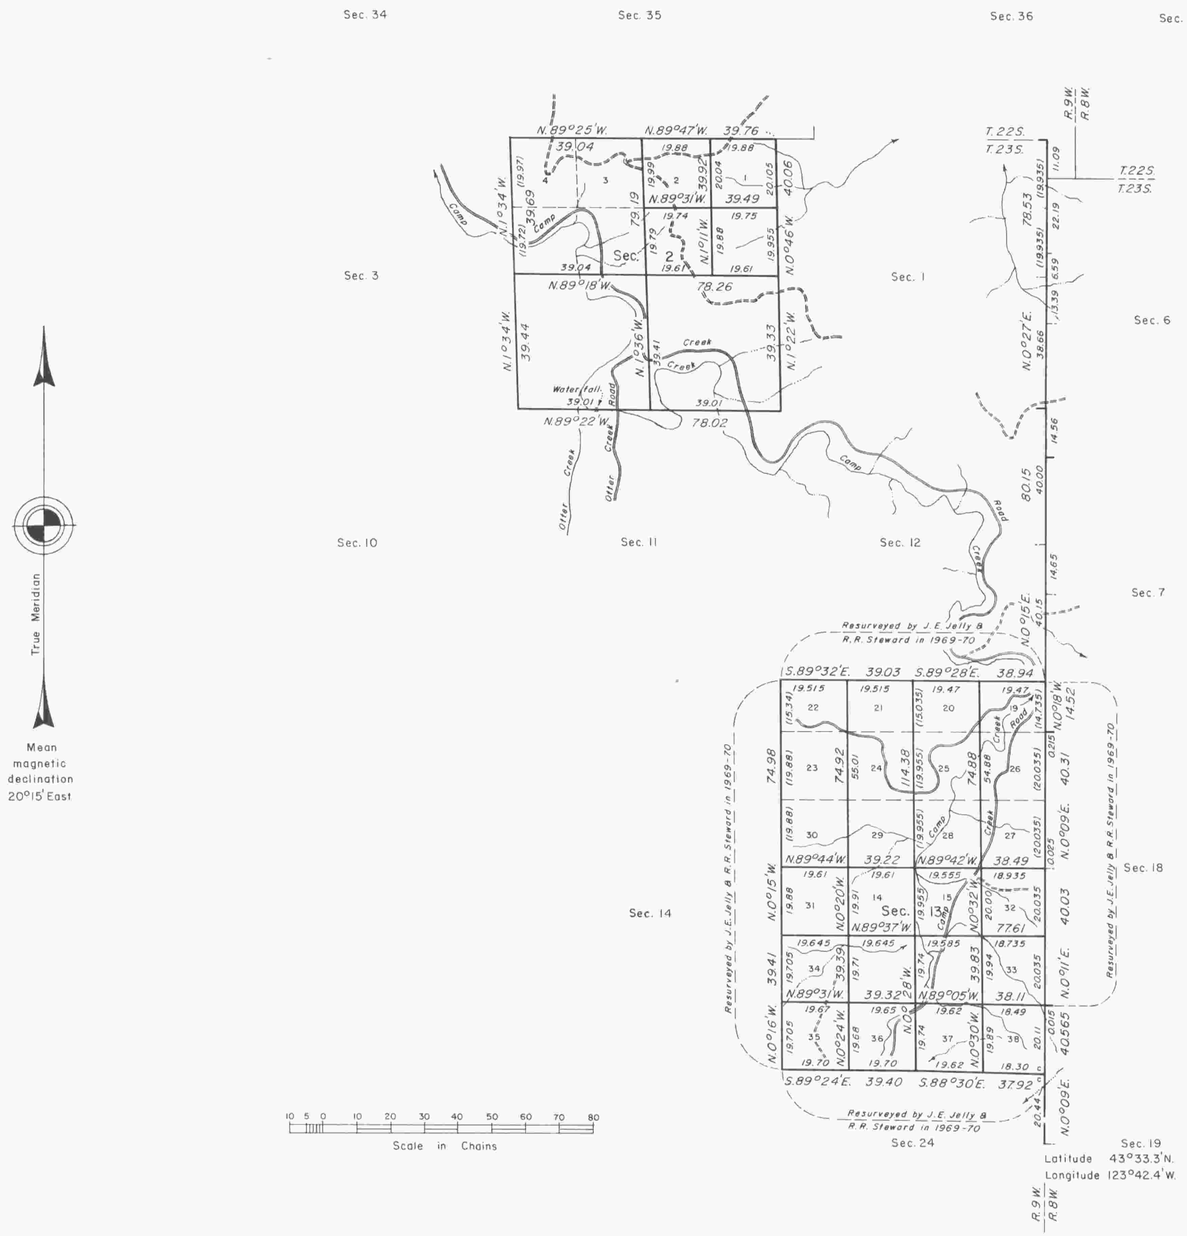

A history of surveys is contained in the field notes.

This plat represents a dependent resurvey of a portion of the west boundary, T. 23 S., R. 8 W., a portion of the north and east boundaries, and subdivisional lines, T. 23 S., R. 9 W., Willamette Meridian, Oregon, designed to restore the corners in their true original locations according to the best available evidence, and the subdivision of sections 2 and 13.

The lottings and areas are as shown on the plats approved July 31, 1878, July 26, 1879, and June 12, 1900, and accepted November 16, 1972.

The survey was executed by Harvey E. Wofford and Stephen J. Malloy, Cadastral Surveyors, beginning July 28, 1980 and completed November 11, 1982, pursuant to Special Instructions dated December 7, 1979, and Second Supplemental Special Instructions dated September 28, 1982, for Group No. 1005, Oregon, and Special Instructions dated July 20, 1981 for Group No. 1074, Oregon.

Timber in this area consists of fir, hemlock, alder, chinquapin, cedar, myrtle, madrone, and dogwood.

UNITED STATES DEPARTMENT OF THE INTERIOR
BUREAU OF LAND MANAGEMENT
Portland, Oregon April 14, 1983

This plat is strictly conformable to the approved field notes, and the survey, having been correctly executed in accordance with the requirements of law and the regulations of this Bureau, is hereby accepted.

For the Director

William W. Glenn

Chief Cadastral Surveyor of Oregon

rfb