Township No. 24 South Range No. 1 West of the Willamette Meridian Oregon

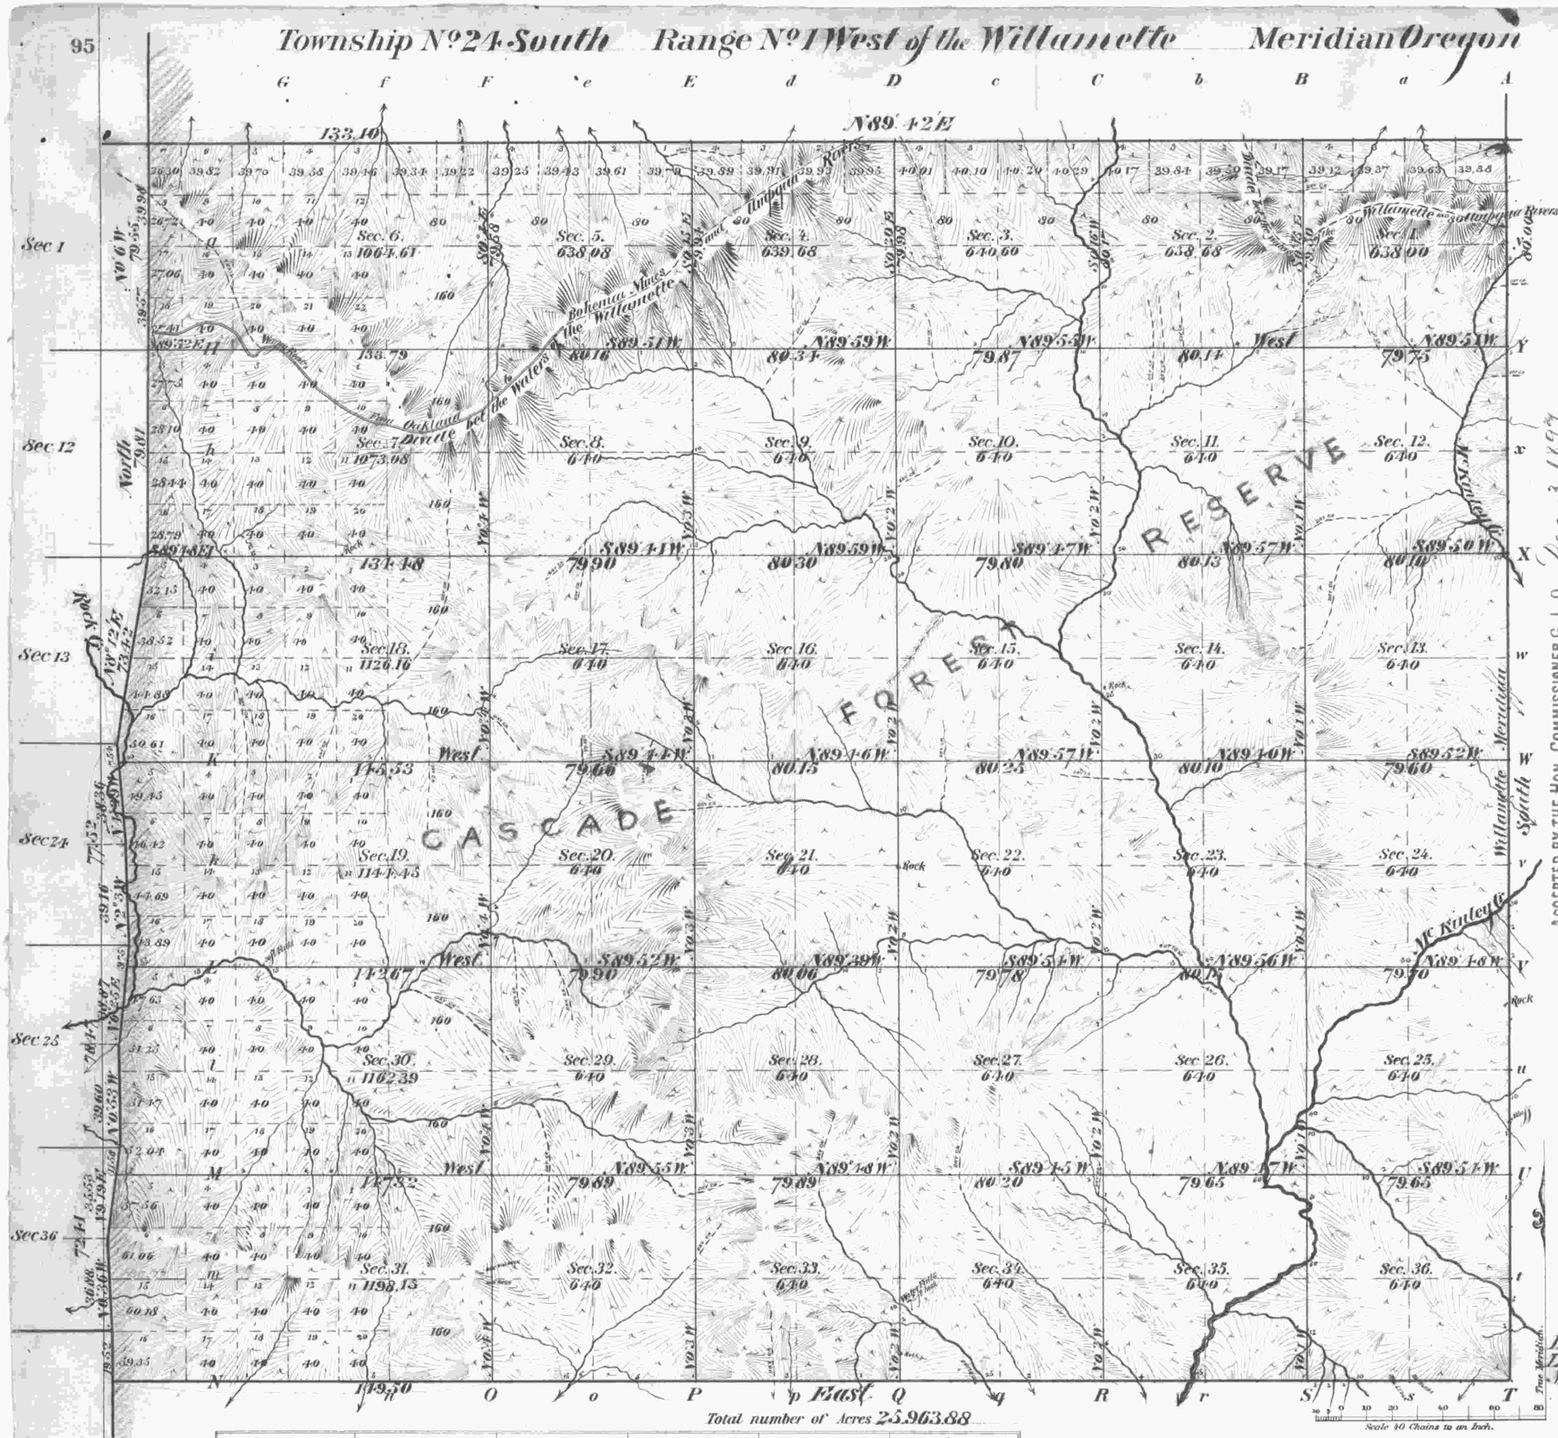

Total number of Acres 25,963.88

Surveys Designated	By Whom Surveyed	Date of Contract	Amount of Surveys M.	Ch.s	Lks	When Surveyed	No. of Contract
Township lines South & East Bdys	Curt S. Nicklin	May 23 1896				July 12 to 20 1896	664
Subdivisions	" " "	" " "	63	62	08	21 27 "	"
Connections	" "			28	87		"
Re-traverse of W Bdy of Tp	"						"
North and West Bdries of Tp	Henry L. Chandler	June 5 1895				1894	619

Meanders of

Posts	Courses	Ch.s Lks	Posts	Courses	Ch.s Lks	Posts	Courses	Ch.s Lks

ACCEPTED BY THE HON. COMMISSIONER G. L. O. Dec. 3 1897

Latitude 43° 32' N. Longitude 122° 47' W. } Ill. Comp. in N.E. ¼ of Section 4
Mean mag. dec'l 15° 30' E.

The above Map of Township No. 24 South of Range No. 1 West of the Willamette Meridian, Oregon, is strictly conformable to the field notes of the survey thereof on file in this Office, which have been examined and approved.

Surveyor Generals Office.
Portland Oregon Aug 10 1897

Robert A. Habersham
Sur. Gen.l for Oregon