TOWNSHIP 24 SOUTH, RANGE 3 WEST, OF THE WILLAMETTE MERIDIAN, OREGON

DEPENDENT RESURVEY AND SUBDIVISION OF SECTION 5

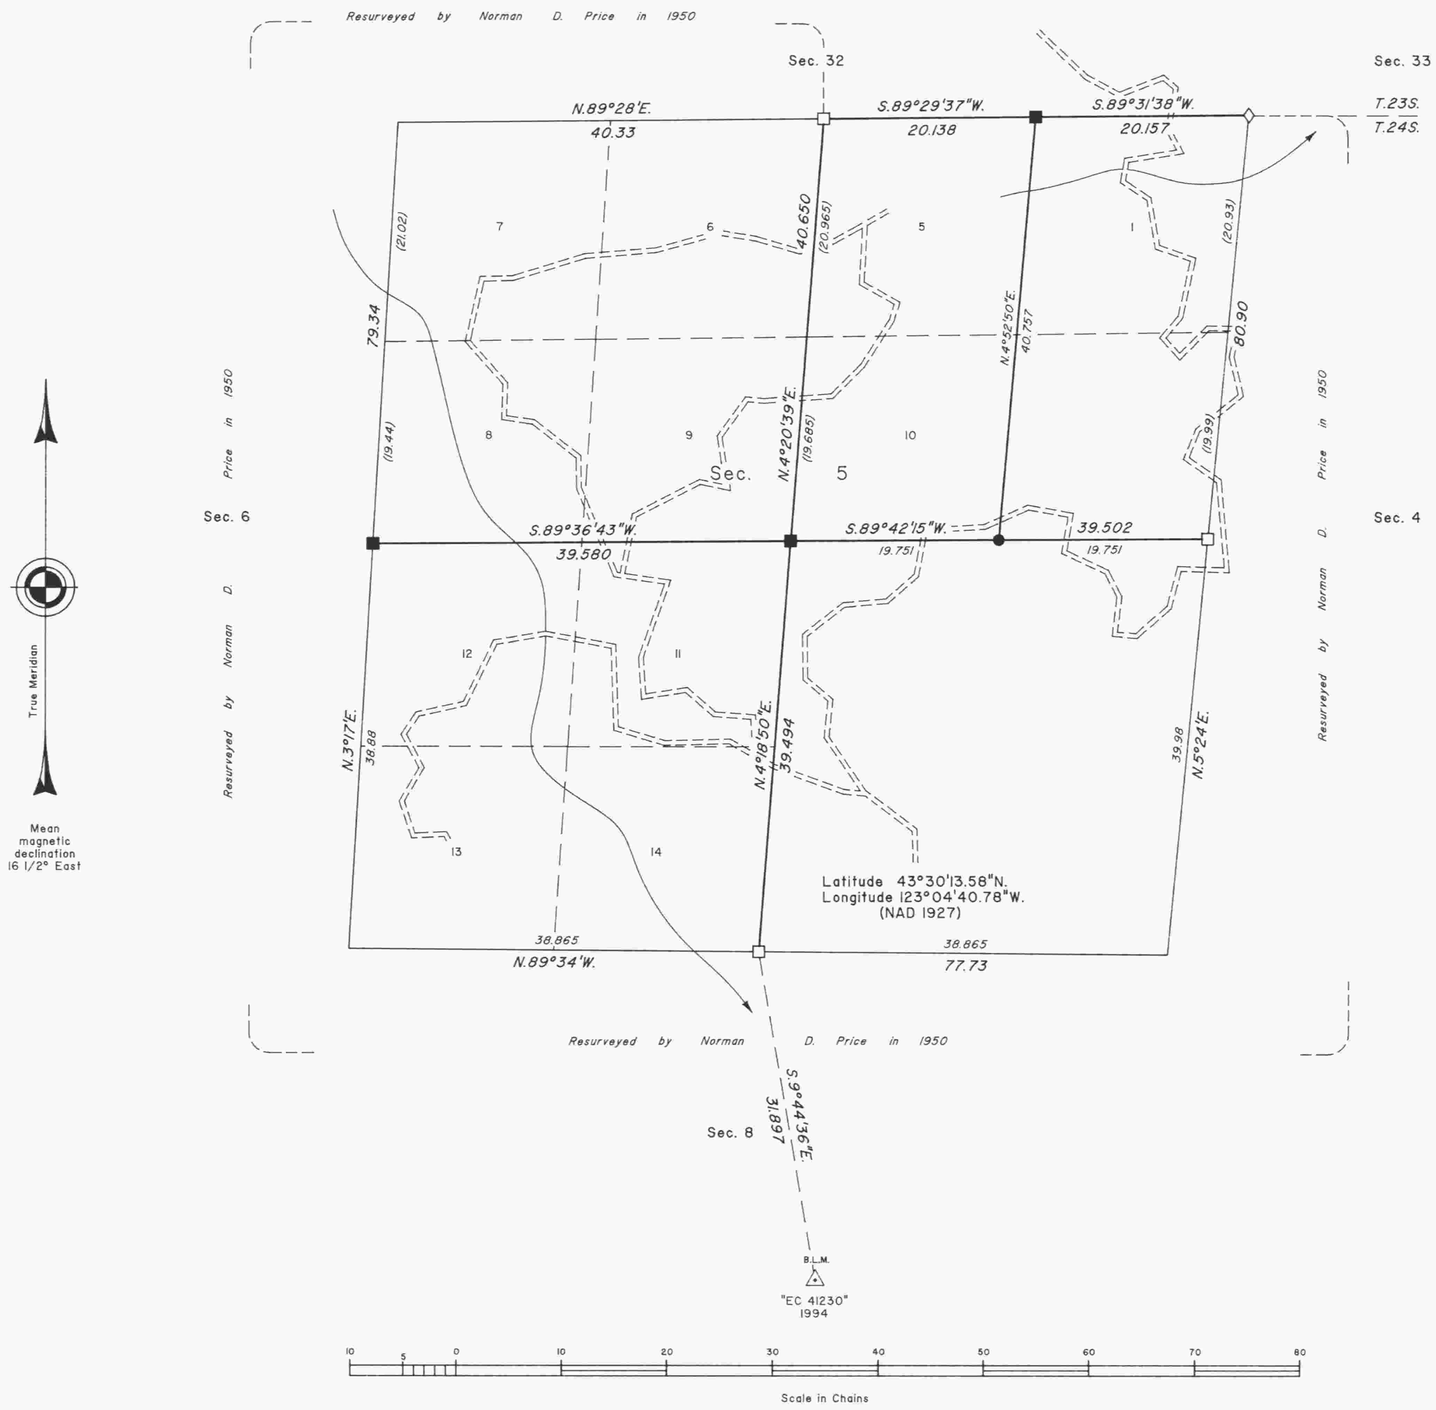

A history of surveys is contained in the field notes.

This plat represents a dependent resurvey of a portion of the north boundary, T. 24 S., R. 3 W., Willamette Meridian, Oregon, designed to restore the corners in their true original locations according to the best available evidence, and the subdivision of section 5.

Measured distances and directions have been adjusted by Cadastral Measurement Management (CMM), a computer program that incorporates a least squares adjustment routine. The adjusted bearings and distances are reported to the nearest second and 0.001 chain.

The lottings and areas are as shown on the plat approved April 26, 1872, and the plat accepted December 3, 1951.

The survey was executed by Bryan S. Seibold, Casastral Surveyor, and Robert H. Browning, Surveying Technician,, beginning July 26, 1994, and completed October 18, 1994, pursuant to Special Instructions dated July 12, 1994, under Group Number 1739, Oregon.

Timber in this are consists of fir, cedar, spruce, yew, pine, hemlock, cherry, maple, oak, willow, ash, madrone, and chinquapin.

The tie to the geodetic control station is reported as mean bearing and sea level distance.

LEGEND

- ◇ Original corner previously remonumented
- □ Corner previously established or reestablished
- ■ Corner previously established or reestablished; remonumented this survey
- ● Corner established or reestablished this survey

UNITED STATES DEPARTMENT OF THE INTERIOR
BUREAU OF LAND MANAGEMENT

Portland, Oregon — February 4, 1998

This plat is strictly conformable to the approved field notes, and the survey, having been correctly executed in accordance with the requirements of law and the regulations of this Bureau, is hereby accepted.

For the Director

Wayne H. Gardner

Chief Cadastral Surveyor of Oregon