Township No. 24 South Range No. 4 West of the Willamette Meridian Oregon

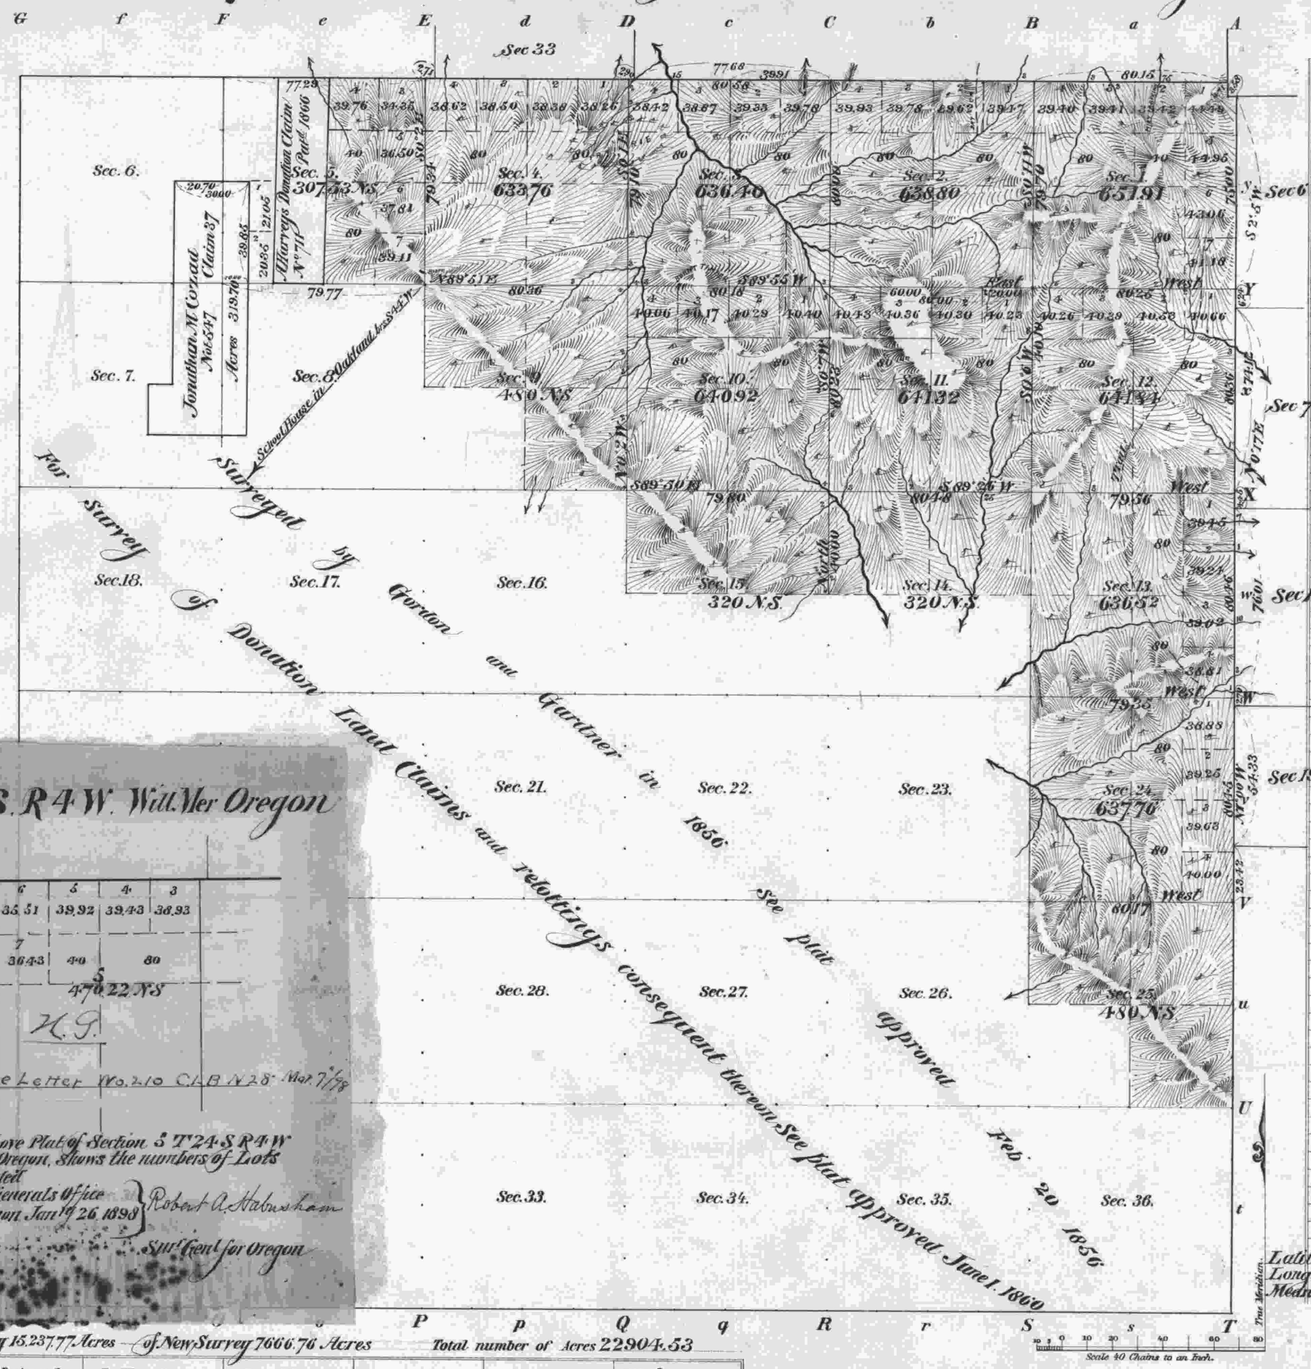

T24 S. R4 W. Will. Mer Oregon

6	5	4	3
35.51	39.92	39.43	36.93
7			
36.43	40	80	

5
470.22 N.S

H. G.

See Letter No. 210 C.L.B. N 28 Mar 7/98

The above Plat of Section 5 T24 S R4 W Will. Mer Oregon, shows the numbers of Lots as amended
Surveyor Generals Office Portland Oregon Jany 26 1898 } Robert A. Habersham Sur^r Genl for Oregon

Meanders of

Posts	Courses	Ch^s Lk^s	Posts	Courses	Ch^s Lk^s	Posts	Courses	Ch^s Lk^s

Jany 18 1898 Letter No. 166 C.L.B. 28
" " " 260 " " 29
May 18 1898

ACCEPTED BY THE HON. COMMISSIONER G. L. O.

Latitude 43° 28' N
Longitude 123° 7' W of G } At corner to Sec^s 23, 24, 25 and 26
Mean mag dec^n 19° 32' E

Area of Former Survey 15,237.77 Acres — of New Survey 7666.76 Acres — Total number of Acres 22904.53

Surveys Designated	By Whom Surveyed	Date of Contract	Amount of Surveys M.	Ch^s	Lk^s	When Surveyed	No. of Contract
Township lines							
Subdivisions	Oscar F. Thiel	May 21 1896	14	18	62	Sep^t 16 1896 to Sep^t 7 1897	658
Retracing of E B^dies of Sec^s 6	" " "	" "	5	71	28	" "	"
1, 12, 13, 24 & N B^dies of Sec. 3							
Connections	" " "	" "		42	42	" "	"
West B^dies of Tp	James E. Freeman	May 28 1851				1851	1
South B^dies of Tp. N B^dies of Sec^s 2, 4, 5 & 6 & E B^dies of Sec. 36	Gordon & Gartner	Feb 17 1855				1855	52
E B^dies of Sec^s 1, 12, 13, 24 & 25	Laban H. Wheeler	April 7 1883				1883	467
N B^dies of Sec^s 1 and 2	Chapman & Nicklin	May 21 1896				1897	664

The above Map of Township No. 24 South of Range No. 4 West of the Willamette Meridian Oregon is strictly conformable to the field notes of the survey thereof on file in this Office, which have been examined and approved.

Surveyor Generals Office, Portland Oregon Nov 6 1897 } Robert A. Habersham Sur^r Genl for Oregon

THE NORRIS PETERS CO., LITHO., WASHINGTON, D. C.