5279

ORIGINAL

TOWNSHIP 24 SOUTH, RANGE 4 WEST, OF THE WILLAMETTE MERIDIAN, OREGON.

DEPENDENT RESURVEY, SUBDIVISION, AND REMONUMENTATION

Sec. 6 ⊕ Sec. 5

Sec. 16 ⊕ Sec. 15 Sec. 14

Donation Land Claim No. 46

Sec. 22 Sec. 23 Sec. 24 Sec. 19

Sec. 26 Sec. 30

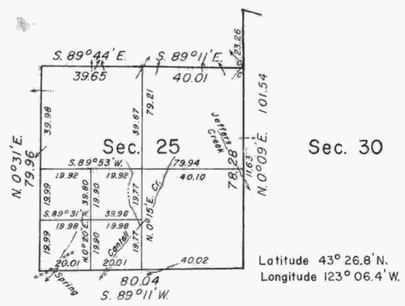

Latitude 43° 26.8' N.
Longitude 123° 06.4' W.

Sec. 35 Sec. 36

True Meridian

Mean Magnetic Declination 19°49' East

10 5 0 10 20 30 40 50 60 70 80
Chains

Area resurveyed: 640 Acres

Timber in this area consists of fir, cedar, madrone, hemlock, oak, dogwood, ash, yew, and alder.

This plat represents a retracement and reestablishment of the north, south, and west boundaries of section 25, and remonumentation of certain original corner points, designed to restore the corners in their true original locations according to the best available evidence. The lottings and areas are as shown on the plats approved February 20, 1856, and November 6, 1897.

The east boundary of section 36 and a portion of the subdivisional lines were surveyed by Gordon and Gardner, in 1855. The north five miles of the east boundary were surveyed by Laban H. Wheeler, in 1883. The survey of the township was completed by Oscar F. Thiel, in 1896-7. The east boundary of the township was resurveyed by Norman D. Price, in 1950. The east boundary of section 36 was resurveyed by William W. Glenn, in 1958. Donation Land Claim No. 46, was surveyed by Dennis Hathorn, in 1856.

The surveys were executed by C. Albert White and Norman J. McDonald, April 16 to July 2, 1963, under Special Instructions dated April 6, 1940, May 3, 1957, and June 11, 1963, for Group Nos. 243, 350, and 513, Oregon.

⊕- Corners remonumented in 1963, under Group No. 350.

UNITED STATES DEPARTMENT OF THE INTERIOR
BUREAU OF LAND MANAGEMENT
Washington, D. C. April 22, 1965

This plat is strictly conformable to the approved field notes, and the survey, having been correctly executed in accordance with the requirements of law and the regulations of this Bureau, is hereby accepted.

For the Director

Chief, Division of Engineering

BmK