TOWNSHIP 24 SOUTH, RANGE 4 WEST, OF THE WILLAMETTE MERIDIAN, OREGON.

SUBDIVISION OF SECTION 33

Sec. 28

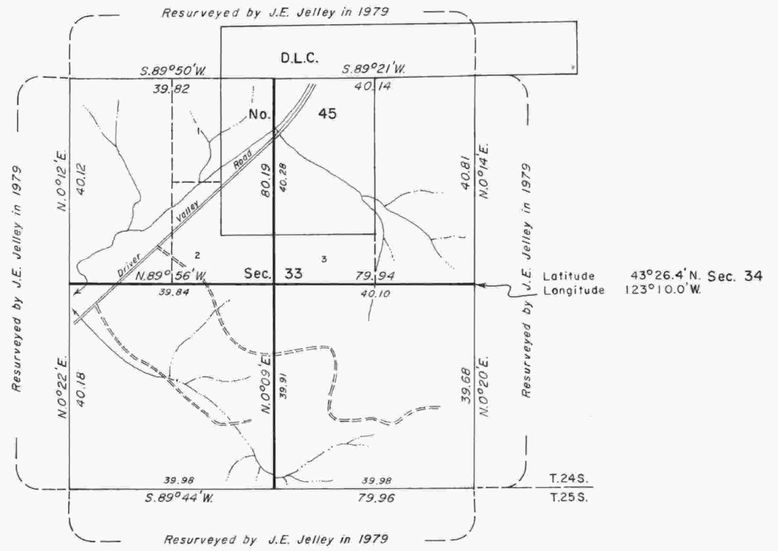

Sec. 4

True Meridian

Mean magnetic declination 19°30' East

10 5 0 10 20 30 40 50 60 70 80

Scale in Chains

A history of surveys is contained in the field notes.

This plat represents the subdivision of section 33, T. 24 S., R. 4 W., Willamette Meridian, Oregon.

The lottings and areas are as shown on the plats approved February 20, 1856 and June 1, 1860.

The survey was executed by Lance J. Bishop and Wayne L. Rogers, Cadastral Surveyors, beginning September 14, 1983, and completed September 19, 1983, pursuant to Special Instructions dated August 30, 1983, under Group Number 1178, Oregon.

Timber in this area consists of fir, hemlock, cedar, maple, oak, chinquapin, alder, and ash.

UNITED STATES DEPARTMENT OF THE INTERIOR
BUREAU OF LAND MANAGEMENT
Portland, Oregon December 13, 1985

This plat is strictly conformable to the approved field notes, and the survey, having been correctly executed in accordance with the requirements of law and the regulations of this Bureau, is hereby accepted.

For the Director

William W. Glenn

Chief Cadastral Surveyor of Oregon

-gee-