7518

ORIGINAL

TOWNSHIP 24 SOUTH, RANGE 4 WEST, OF THE WILLAMETTE MERIDIAN, OREGON

DEPENDENT RESURVEY

FILED
Date: 10/3/2011 By: JC
This survey consists of:
~~Map:~~ VOL 57
~~Narrative:~~ PAGES
~~Corner Rpt:~~ 22602-22611
DOUGLAS COUNTY SURVEYOR

OFFICIALLY FILED: 9/28/2011

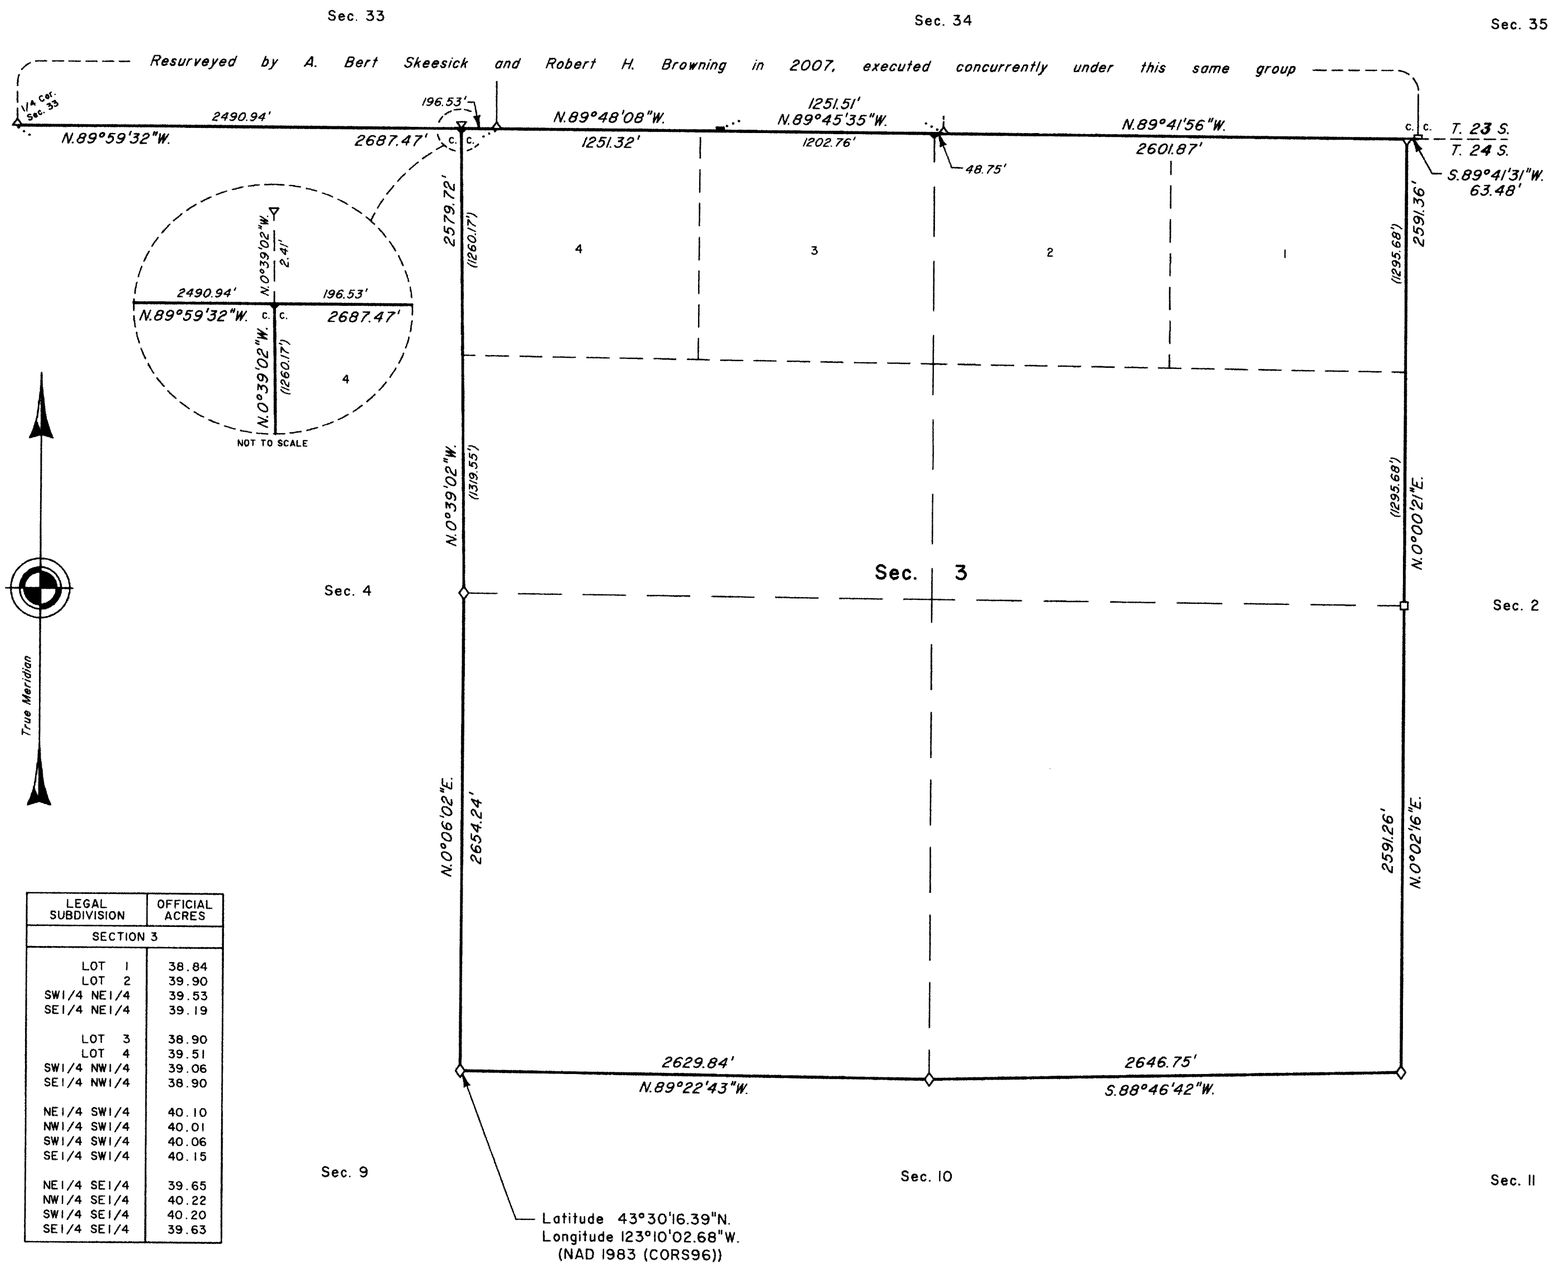

LEGAL SUBDIVISION	OFFICIAL ACRES
SECTION 3	
LOT 1	38.84
LOT 2	39.90
SW1/4 NE1/4	39.53
SE1/4 NE1/4	39.19
LOT 3	38.90
LOT 4	39.51
SW1/4 NW1/4	39.06
SE1/4 NW1/4	38.90
NE1/4 SW1/4	40.10
NW1/4 SW1/4	40.01
SW1/4 SW1/4	40.06
SE1/4 SW1/4	40.15
NE1/4 SE1/4	39.65
NW1/4 SE1/4	40.22
SW1/4 SE1/4	40.20
SE1/4 SE1/4	39.63

A history of surveys is contained in the field notes.

This plat represents a dependent resurvey of a portion of the subdivisional lines, T. 24 S., R. 4 W., Willamette Meridian, Oregon, designed to restore the corners in their true original locations according to the best available evidence.

The survey was performed utilizing both conventional (directly measured angles and distances) and NAVSTAR Global Positioning System (GPS) satellite techniques. The GPS measurements utilized dual frequency, carrier phase GPS receivers. The baselines were computed in and adjusted by least squares analysis using Trimble Geomatics Office (TGO). Conventionally measured distances and directions have been adjusted by Cadastral Measurement Management for Windows (WinCMM), computer software that incorporates a least squares adjustment routine. The adjusted bearings and distances are reported to the nearest second and 0.01 foot.

Actual quantity acreages have been returned for Federal interest lands where indicated. Changes in the official acreage of land described by aliquot part or lot number do not alter its description. Further subdivision of aliquot parts shall be in accordance with the Manual. Further subdivision of official lots may only be by supplemental plat or official survey. Official acreage and lot designations of Federal interest land not affected by this survey are as shown on the plat approved November 6, 1897, and amended January 26, 1898.

The survey was executed by A. Bert Skeesick, Cadastral Surveyor, and Robert H. Browning, Surveying Technician, beginning May 29, 2007, and completed November 6, 2007, pursuant to Special Instructions dated April 17, 2007, under Group Number 2168, Oregon.

LEGEND

- ◇ Original corner previously remonumented
- □ Corner previously established or reestablished
- ■ Corner previously established or reestablished; remonumented this survey
- ● Corner established or reestablished this survey

UNITED STATES DEPARTMENT OF THE INTERIOR
BUREAU OF LAND MANAGEMENT

Portland, Oregon

This plat is strictly conformable to the approved field notes, and the survey, having been correctly executed in accordance with the requirements of law and the regulations of this Bureau, is hereby accepted.

For the Director

Mary J. M. Hartel

Chief Cadastral Surveyor of Oregon

July 18, 2011
Date

33