ORIGINAL

# TOWNSHIP 24 SOUTH, RANGE 6 WEST, OF THE WILLAMETTE MERIDIAN, OREGON.

## DEPENDENT RESURVEY AND SUBDIVISION

Sec. 13 | Sec. 18 | Sec. 17

Sec. 24 | Sec. 19 | Sec. 20

Sec. 25 | Sec. 30 | Sec. 29

Mean magnetic declination

20° East

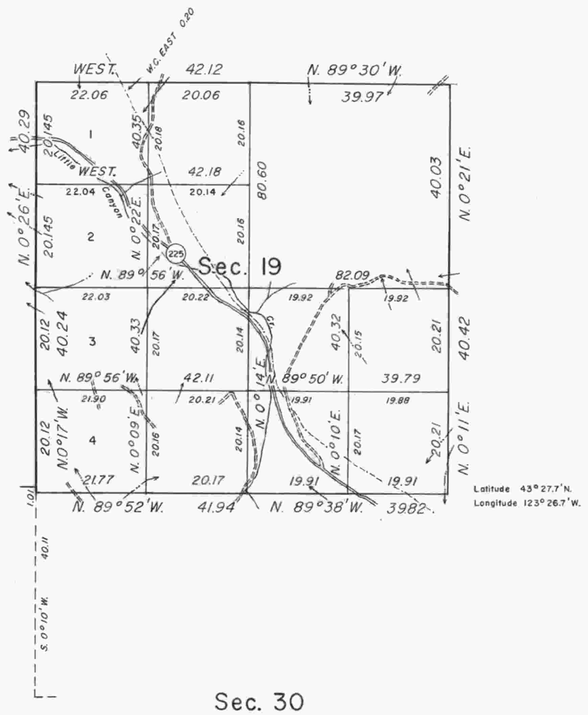

Area resurveyed - 654.34 Acres

Timber in this area consists mostly of Douglas fir with lesser amounts of hemlock, cedar, white fir, myrtle, white oak, black oak, madrone, willow, yew, alder, maple, and chinquapin.

This plat represents a retracement and reestablishment of a portion of the west boundary and a portion of the subdivisional lines of T. 24 S., R. 6 W., Willamette Meridian, Oregon, designed to restore the corners in their true original location according to the best available evidence; and, the lottings and areas are as shown on the plat approved February 3, 1892.

The west boundary was surveyed by Robert Elder and Henry S. Gile in 1853. The subdivisional lines were surveyed by Williams R. Whipple in 1891. In 1893, Whipple retraced the west boundary of section 30.

Dependent resurvey of a portion of the west boundary and a portion of the subdivisional lines of T. 24 S., R. 6 W., and subdivision of section 19, T. 24 S., R. 6 W., Willamette Meridian, Oregon, executed by Joseph S. Gawron, May 2 to June 14, 1962, under Special Instructions dated August 22, 1961, which provide for the surveys included under Group No. 464, Oregon.

UNITED STATES DEPARTMENT OF THE INTERIOR
BUREAU OF LAND MANAGEMENT
Washington, D. C. September 27, 1963

This plat is strictly conformable to the approved field notes, and the survey, having been correctly executed in accordance with the requirements of law and the regulations of this Bureau, is hereby accepted.

For the Director

R. E. Brown

Acting Chief, Division of Engineering

B.M.K.