5792

ORIGINAL

TOWNSHIP 24 SOUTH, RANGE 6 WEST, OF THE WILLAMETTE MERIDIAN, OREGON.

DEPENDENT RESURVEY

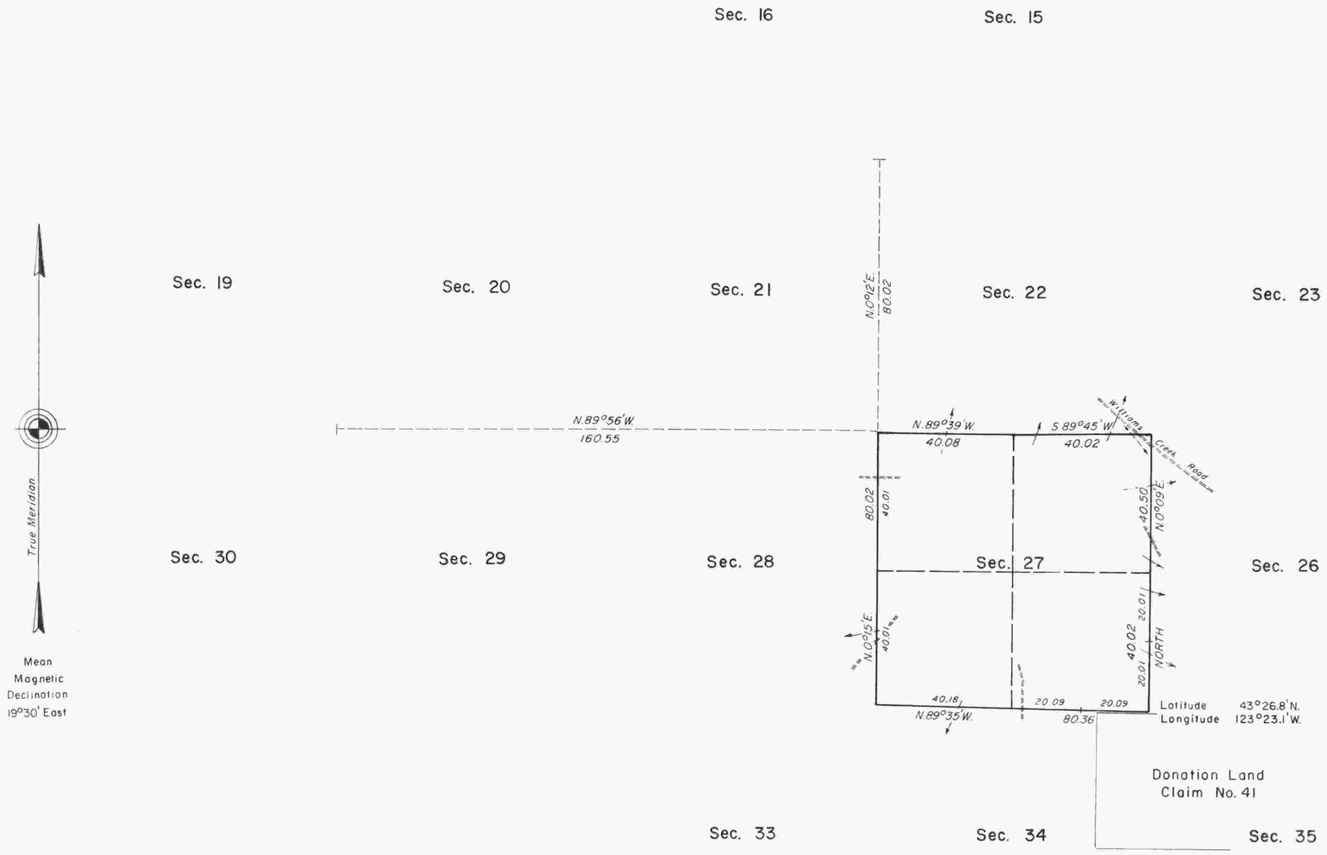

This plat represents a dependent resurvey of a portion of the subdivisional lines designed to restore the corners in their true original locations according to the best available evidence, T. 24 S., R. 6 W., Willamette Meridian, Oregon.

The lottings and areas are as shown on the plat approved June 30, 1853.

A portion of the subdivisional lines was surveyed by Robert Elder and Henry S. Gile in 1853.

A portion of the subdivisional lines was surveyed by Williams R. Whipple in 1891.

A portion of the subdivisional lines was resurveyed and sec. 19 was subdivided by Joseph S. Gawron in 1962.

A portion of the subdivisional lines was resurveyed by Daniel L. Berry and Charles E. Akin Jr., in 1973-74.

Survey executed by Wayne L. Rogers, Cadastral Surveyor beginning April 4, 1979, and completed May 3, 1979, pursuant to Special Instructions dated January 22, 1979, for Group No. 969, Oregon.

UNITED STATES DEPARTMENT OF THE INTERIOR
BUREAU OF LAND MANAGEMENT
Denver, Colorado February 5, 1982

This plat is strictly conformable to the approved field notes, and the survey, having been correctly executed in accordance with the requirements of law and the regulations of this Bureau, is hereby accepted.

For the Director

Gary L. Spright

Acting Chief, Cadastral Survey
Examination and Approval Staff

Timber in this area consists of fir, oak, madrone, cedar, willow, and ash.

10 5 0 10 20 30 40 50 60 70 80
Scale in Chains

gee